

K 5  
6-17-63

WATER WELL DRILLERS LOG

Date: June 17, 1963 Driller: Porter Drilling & Log Co. Wayne  
(Name)

(1) Owner of Land: Troy Shirley  
(Name)  
Rt 2 Waynesboro  
(Address)  
(2) Location: NE 1/4, SE 1/4, Sec. 32 T9 R5  
10 miles east, of \_\_\_\_\_  
(distance) (direction) (Nearest Town)  
(3) Topography: hilly  
(Hilly) (Flat) (Level)  
(4) Purpose of Well: water chickens  
(Domestic Irrigation  
Municipal, Industrial, Other)

Description & Color of Materials Sand, Clay, Red Clay, Shell, etc.	Thick- ness Feet	Depth Feet
<u>sandy clay</u>	<u>5</u>	<u>5</u>
<u>red chert</u>	<u>5</u>	<u>10</u>
<u>chert &amp; sand</u>	<u>8</u>	<u>18</u>
<u>hard dark chert</u>	<u>26</u>	<u>44</u>
<u>honeysuck rock</u>	<u>14</u>	<u>58</u>
<u>suff. sh. &amp; shale</u>	<u>16</u>	<u>74</u>
<u>white chert</u>	<u>8</u>	<u>82</u>


Information upon completion of well:

(1) Diameter 2" inches.  
(2) Total Depth 82' feet.  
(3) Water Level 27' feet below top of ground.  
(4) Cased to 44 1/2', Size 2"  
(5) Screen: Size none, Length \_\_\_\_\_  
(6) Were any formations sealed against pollution?  
\_\_\_\_\_ yes, X no.

If YES depth of formation \_\_\_\_\_

Why \_\_\_\_\_

Drillers Remarks: \_\_\_\_\_

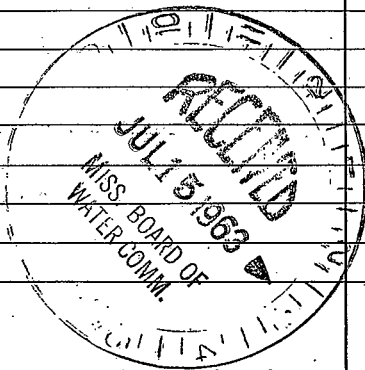

(Use Back Side)

Well No.

