

Wayne
K7
10/67

MISSISSIPPI
BOARD OF WATER COMMISSIONERS
416 North State Street
Jackson, Mississippi 39201

WATER WELL DRILLERS LOG

Oct 29 1967 Porter Drilling & Log Wayne
date well completed firm name county well located

LANDOWNER: Antioch Miss. Baptist Church

Rt 2 Waynesboro
(mailing address)

WELL LOCATION:
sec 20 T 90 N 5 W
R 17 E W
9 miles West of Waynesboro
(distance) (direction) (nearest town)

WELL PURPOSE: chuck
(home, irrigation, municipal, industrial)

WELL COMPLETION DATA:


- (1) diameter (inches) 2"
- (2) total depth (feet) 151'
- (3) static water level (feet) 102' below top of ground.
- (4) casing steel, 121'
(material) (depth)
2" if telescope see back.
(size)
- (5) screen 10', 124'
(length) (depth to top)
1/4", 60ga brass jacket
(size) (material)
- (6) pump 1/2 6
(HP) (yield gpm)
elec
(type power)
- (7) electric log no
(yes or no)

(organization running log)

(8) how well bottom plugged steel plug


DRILLERS REMARKS:

description of formations encountered	from	to
<u>red clay & sand</u>	<u>0</u>	<u>30</u>
<u>red chkb</u>	<u>30</u>	<u>102</u>
<u>thin rock</u>		<u>102</u>
<u>blue chkb</u>	<u>102</u>	<u>121</u>
<u>thin rock</u>		<u>121</u>
<u>sand & some chkb</u>	<u>121</u>	<u>134</u>
<u>rock</u>	<u>134</u>	<u>135</u>
<u>blue chkb</u>	<u>135</u>	<u>151</u>

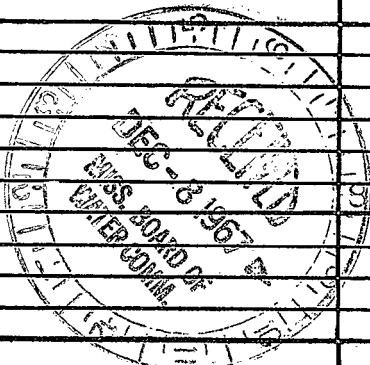

If well telescopes please sketch and show depths.

GROUND LEVEL

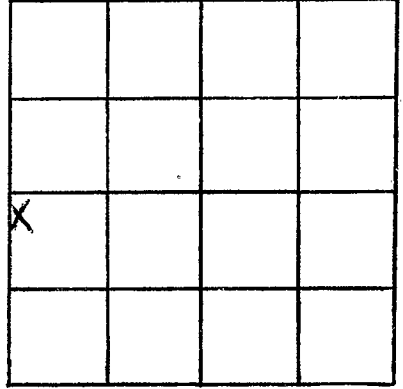

SECTION 20

Please indicate well location X.

ADDITIONAL INFORMATION

If more than one screen, show locations of each on sketch.