

Wayne  
K8  
10/67

MISSISSIPPI  
BOARD OF WATER COMMISSIONERS  
416 North State Street  
Jackson, Mississippi 39201

WATER WELL DRILLERS LOG

Oct 27, 1967 date well completed  
Dade Drilling & Exp firm name  
Wayne county well located


LANDOWNER: Mr. Clara  
Mrs. Loughton  
Rt 2 Waynesboro  
(mailing address)

description of formations encountered	from	to
red clay	0	15
loose formation		
lost circulation	15	22
rock strata	22	35
blue chalk	35	51

WELL LOCATION: SW  
sec. 30 T 9 N R 17 W  
S  
W  
8 miles east of Waynesboro  
(distance) (direction) (nearest town)

WELL PURPOSE: Home  
(home, irrigation, municipal, industrial)


- WELL COMPLETION DATA:
- (1) diameter (inches) 2"
  - (2) total depth (feet) 51
  - (3) static water level (feet) 21 below above top of ground.
  - (4) casing steel, 24' (material) (depth)  
2' (size) If telescope see back.
  - (5) screen none, used (length) (depth to top)  
(size) (material)
  - (6) pump 1/2 (HP) 5 (yield gpm)  
elec (type power)
  - (7) electric log no (yes or no)  
(organization running log)
  - (8) how well bottom plugged open

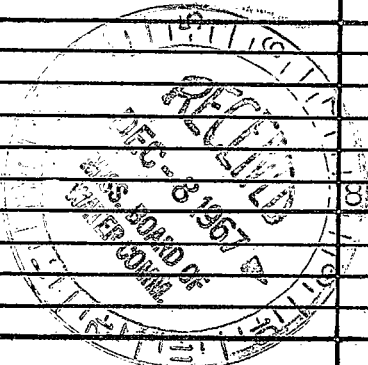

DRILLERS REMARKS:

If well telescopes please sketch and show depths.

GROUND LEVEL

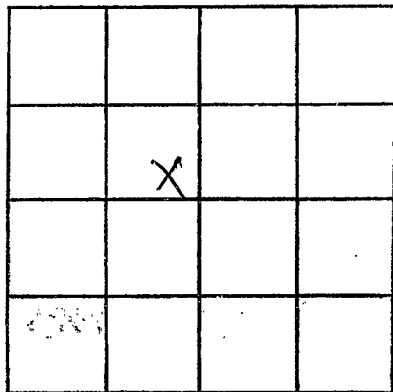

SECTION 30

Please indicate well location X.

ADDITIONAL INFORMATION

If more than one screen,  
show locations of each on sketch.