

WAYNE
K9
3-68

MISSISSIPPI
BOARD OF WATER COMMISSIONERS
416 North State Street
Jackson, Mississippi 39201

WATER WELL DRILLERS LOG

March 7 1968 Porter Drilling Co Wayne
date well completed firm name county well located

LANDOWNER: M. N. Atkinson

description of formations encountered

from to

Box 2 Waynesboro Miss
(mailing address)

WELL LOCATION:


sec 30 T 9 S R 5 W
8 miles NE of Waynesboro
(distance) (direction) (nearest town)

WELL PURPOSE: domestic
(home, irrigation, municipal, industrial)

WELL COMPLETION DATA:

- (1) diameter (inches) 2'
- (2) total depth (feet) 290'
- (3) static water level (feet) small flow below above
top of ground.
- (4) casing steel 242 1/2'
(material) (depth)
2'' If telescope see back.
(size)
- (5) screen none, used
(length) (depth to top)
(size) (material)
- (6) pump 1/2 10
(HP) (yield gpm)
elec
(type power)
- (7) electric log no
(yes or no)
(organization running log)
- (8) how well bottom plugged: open


description of formations encountered	from	to
sand	0	17 1/2
rock	17 1/2	22
white chalk	22	29
lime rock	29	33
white chalk	33	57
blue chalk	57	175
thin rock		175
blue chalk	175	220
soft rock strata	220	244
fine clean sand	244	249
fine sand & chalk	249	257
thin rock		257
thin rock		264
fine sand & chalk	257	264
mostly fine sand	264	275
rock	275	276
Chalk & rock layers	276	290

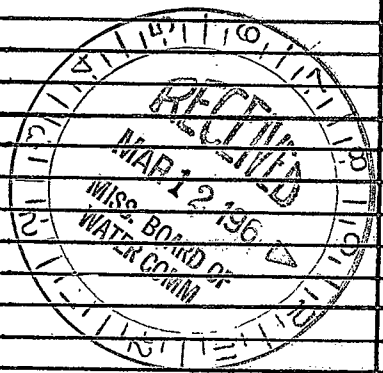

DRILLERS REMARKS:

If well telescopes please sketch and show depths.

GROUND LEVEL

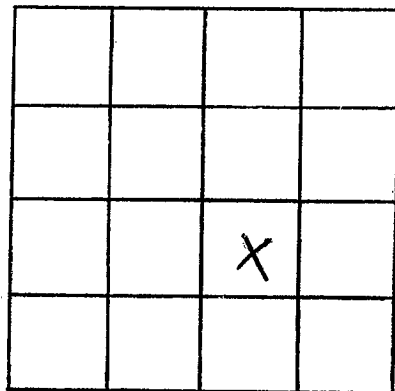

SECTION 30

Please indicate well location X.

ADDITIONAL INFORMATION

If more than one screen,
show locations of each on sketch.