

WAYNE
K 10
4-68

MISSISSIPPI
BOARD OF WATER COMMISSIONERS
416 North State Street
Jackson, Mississippi 39201

WATER WELL DRILLERS LOG

April 1, 1968 Porter Drilling Co Wayne
date well completed firm name county well located

LANDOWNER: Troy Shirley

description of formations encountered	from	to
sand & chalk	0	15
blue chalk	15	49
Wichitanga ^{rock} conglomerate	49	76
white chalk	76	80


At 2 Waynesboro Miss
(mailing address)

WELL LOCATION:
sec 32 T 9 N R 5 E
S W
8 miles east of Waynesboro
(distance) (direction) (nearest town)

WELL PURPOSE: ten hours
(home, irrigation, municipal, industrial)

WELL COMPLETION DATA:

- (1) diameter (inches) 2
- (2) total depth (feet) 80
- (3) static water level (feet) 36 ^{below} ~~above~~ top of ground.
- (4) casing steel 49 1/2
(material) (depth)
2' if telescope see back.
(size)
- (5) screen none used
(length) (depth to top)
(size) (material)
- (6) pump 1 12
(HP) (yield gpm)
elec
(type power)
- (7) electric log no
(yes or no)
(organization running log)
- (8) how well bottom plugged open end

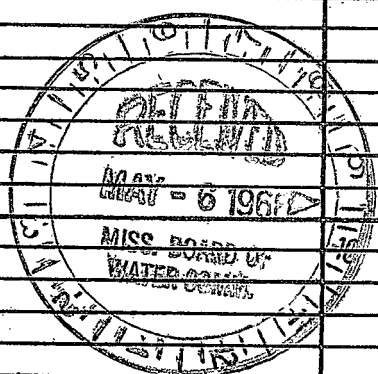

DRILLERS REMARKS:
2' cas sealed into rock with 3 1/2" casing

If well telescopes please sketch and show depths.

GROUND LEVEL

			X

SECTION 32

Please indicate well location X.

ADDITIONAL INFORMATION

If more than one screen,
show locations of each on sketch.