

Wayne
 R-12
 11-4-68

MISSISSIPPI
 BOARD OF WATER COMMISSIONERS
 416 North State Street
 Jackson, Mississippi 39201

CODED

WATER WELL DRILLERS LOG

Nov 4 1968 Bohrer Drilling & Log Wayne
 date well completed firm name county well located

LANDOWNER: George J. Everett
212 Wayneboro Miss
 (mailing address)

description of formations encountered	from	to
pebble clay + sand	0	15
blue shales	15	41
the harbor limestone		
0 rocks	41	60
white chalk	60	64

WELL LOCATION:
 sec. 32 T. 9 N. R. 5 E.
 S W
9 miles NE of Waynesboro
 (distance) (direction) (nearest town)

WELL PURPOSE:
 (home, irrigation, municipal, industrial)

WELL COMPLETION DATA:

- (1) diameter (inches) 2"
- (2) total depth (feet) 64'
- (3) static water level (feet) 19' below above top of ground.
- (4) casing steel, 41'
 (material) (depth)
2" if telescope see back.
 (size)
- (5) screen none used
 (length) (depth to top)
 (size) (material)
- (6) pump 1/2 3 1/2
 (HP) (yield gpm)
elec.
 (type power)
- (7) electric log none
 (yes or no)

3 1/2 bush on end of cas

CODED

(organization running log)

(8) how well bottom plugged open


DRILLERS REMARKS:

NOV 7 1968

MISS. BD. OF WATER COMMISSIONERS

If well telescopes please sketch and show depths.

GROUND LEVEL

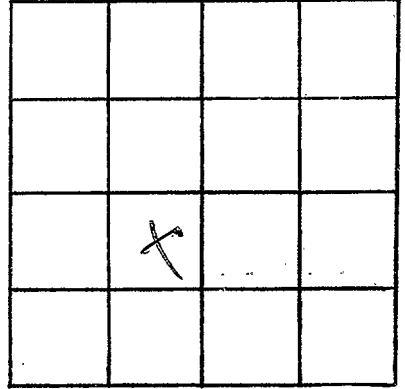

SECTION 32

Please indicate well location X.

ADDITIONAL INFORMATION

If more than one screen, show locations of each on sketch.