

WAYNE  
K 14  
12-29-71

MISSISSIPPI  
BOARD OF WATER COMMISSIONERS  
416 North State Street  
Jackson, Mississippi 39201

WATER WELL DRILLERS LOG

Dec 29 1971 Risen Water Well Wayne  
date well completed firm name county well located

LANDOWNER:

Mrs. Mary Walker  
Rt. 4, Waynesboro, Miss.  
(mailing address)

description of formations encountered

from to

Red sand	0	20
Red & white sand	20	40
Red gravel sand	40	50
White gravel sand	50	67
Total	67	feet

WELL LOCATION:

sec. 27 T 9 N R 5 E  
S  
9 miles East of Waynesboro  
(distance) (direction) (nearest town)

WELL PURPOSE: TOILET  
(home, irrigation, municipal, industrial)

WELL COMPLETION DATA:


- (1) diameter (inches) 4"
- (2) total depth (feet) 67'
- (3) static water level (feet) 52' below above top of ground.
- (4) casing 2" 64'  
(material) (depth)
- (size) if telescope see back.
- (5) screen 3' 67'  
(length) (depth to top)
- (size) 1 1/4" 609 Brass lined drive pipe  
(material)
- (6) Hand Red Pump 3  
(HP) (yield gpm)
- (type power) Hand Pump
- (7) electric log NO  
(yes or no)
- (organization running log)
- (8) how well bottom plugged drive point

JAN 6 1972  
MISS. Bd. of WATER COMMISSIONERS

DRILLERS REMARKS: Good

If well telescopes please sketch and show depths.

GROUND LEVEL

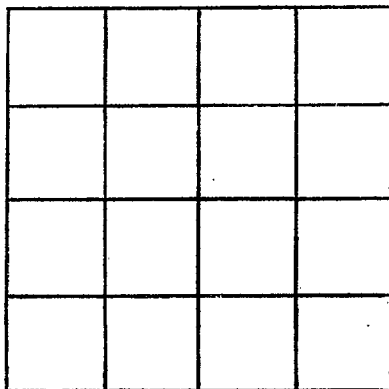

SECTION \_\_\_\_\_

Please indicate well location X.

ADDITIONAL INFORMATION

If more than one screen,  
show locations of each on sketch.