

WAYNE
K16
1-4-74

MISSISSIPPI
 BOARD OF WATER COMMISSIONERS
 416 North State Street
 Jackson, Mississippi 39201

CODED

WATER WELL DRILLERS LOG

McILWAIN WATER WELL SERVICE WAYNE

JAN 4, 1974
 date well completed

RT. 4 BOX 37
 firm name

county well located

WAYNESBORO, MISS. 39367

LANDOWNER:
FRAZIER WHITE
RT 2 WAYNESBORO, MISS.
 (mailing address)

description of formations encountered	from	to
<u>Red Clay</u>	<u>0</u>	<u>8</u>
<u>Brown clay</u>	<u>8</u>	<u>12</u>
<u>White Chalk</u>	<u>12</u>	<u>20</u>
<u>SAND</u>	<u>20</u>	<u>62</u>

WELL LOCATION:
 sec. 27 T. 9 N. R. 5 E
10 miles E of W'BORO
 (distance) (direction) (nearest town)

WELL PURPOSE: HOME
 (home, irrigation, municipal, industrial)

WELL COMPLETION DATA:

(1) diameter (inches) 2"

(2) total depth (feet) 62

(3) static water level (feet) 52 below above top of ground.

(4) casing PVC, 57'
 (material) (depth)
2"
 (size) if telescope see back.

(5) screen 5', 57'
 (length) (depth to top)
2", PVC .008
 (size) (material)

(6) pump 1/2, 6
 (HP) (yield gpm)
110 AC
 (type power)

(7) electric log no
 (yes or no)

(organization running log)

(8) how well bottom plugged


CODED

JAN 1 1974

DRILLERS REMARKS:

If well telescopes please sketch and show depths.

GROUND LEVEL

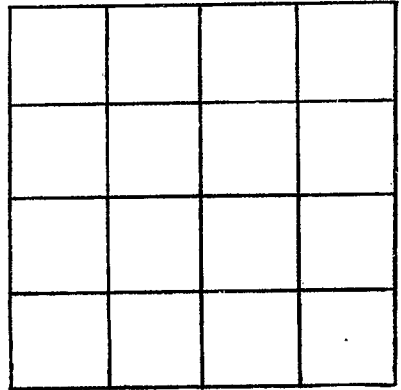

SECTION _____

Please indicate well location X.

ADDITIONAL INFORMATION

If more than one screen, show locations of each on sketch.