

**WAYNE**  
**K 17**  
**3-30-74**

MISSISSIPPI  
 BOARD OF WATER COMMISSIONERS  
 416 North State Street  
 Jackson, Mississippi 39201

**CODED**

**WATER WELL DRILLERS LOG**

**MARCH 30, 74**  
 date well completed

**McILWAIN WATER WELL SERVICE WAYNE**

RT. 2, BOX 37

county well located

WAYNESBORO, MISS. 39362

**LANDOWNER:**

**JOHN HENRY MAYFIELD**

**RT 2, WAYNESBORO, MISS.**  
 (mailing address)

**WELL LOCATION:**

sec **33 T 9 N R 5 E**  
**10** miles **E** of **W'BORO**  
 (distance) (direction) (nearest town)

**WELL PURPOSE: HOME**  
 (home, irrigation, municipal, industrial)

**WELL COMPLETION DATA:**

- (1) diameter (inches) **2"**
- (2) total depth (feet) **195'**
- (3) static water level (feet) **120'** below top of ground.
- (4) casing **PVC**, **145'**  
 (material) (depth)  
**2"** if telescope see back.  
 (size)
- (5) screen **NONE**  
 (length) (depth to top)  
 (size) (material)
- (6) pump **1 1/2** **5.5**  
 (HP) (yield gpm)  
**220 AC**  
 (type power)
- (7) electric log **no**  
 (yes or no)

(organization running log)

(8) how well bottom plugged

description of formations encountered

from to


<b>RED CLAY</b>	<b>0</b>	<b>12</b>
<b>RED SAND</b>	<b>12</b>	<b>30</b>
<b>PEA GRAVEL AND COARSE SAND</b>	<b>30</b>	<b>50</b>
<b>CLAY</b>	<b>50</b>	<b>58</b>
<b>SAND &amp; CLAY</b>	<b>58</b>	<b>60</b>
<b>BLUE CLAY</b>	<b>60</b>	<b>75</b>
<b>ROCK AND LINED LAYERS CODED</b>	<b>75</b>	<b>98</b>
<b>DARK BLUE CLAY</b>	<b>98</b>	<b>143</b>
<b>ROCK AND BREAKS</b>	<b>143</b>	<b>195</b>
<b>FORMATION PACKER</b>		
<b>SET AT 143'</b>		
<b>OPEN HOLE 145' TO 195'</b>		

**DRILLERS REMARKS:**

**APR - 4 1974**

If well telescopes please sketch and show depths.

GROUND LEVEL

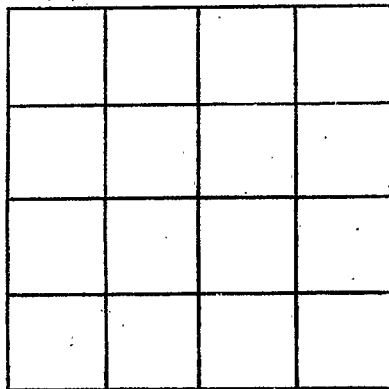

SECTION \_\_\_\_\_

Please indicate well location X.

ADDITIONAL INFORMATION

If more than one screen, show locations of each on sketch.