

WAYNE
K19
5-24-74

MISSISSIPPI
BOARD OF WATER COMMISSIONERS
416 North State Street
Jackson, Mississippi 39201 CODED

WATER WELL DRILLERS LOG

May 24 1974 Porter Drilling & Exp Wayne
date well completed firm name county well located

LANDOWNER: Jim Graham

description of formations encountered from to

Qtz 2 Waynesboro
(mailing address)

red clay 0 18
white rock 18 40
sand chalk 40 75
blue chalk 75 150
blue chert & thin
sand strata 150 246
sandstone cleaved sand 246 256
still in hard sand

WELL LOCATION:

sec. 8 T 9 N R 5 E
9 miles NE of Waynesboro
(distance) (direction) (nearest town)

WELL PURPOSE: home
(home, irrigation, municipal, industrial)

WELL COMPLETION DATA:

- (1) diameter (inches) 2"
- (2) total depth (feet) 256
- (3) static water level (feet) 158 (below top of ground)
- (4) casing steel 246
(material) (depth)
2" if telescope see back.
(size)
- (5) screen 10 246
(length) (depth to top)
1 1/4 bolt SS.
(size) (material)
- (6) pump 3/4 HP 3 1/2
(HP) (yield gpm)
elec
(type power)
- (7) electric log no
(yes or no)
(organization running log)

10" 1 1/4" bolt SS screen
that in well packer
by hand set at 168'

(8) how well bottom plugged


DRILLERS REMARKS:

RECEIVED
JUL 24 1974

MISS. BB. OF WATER COMMISSIONERS

If well telescopes please
sketch and show depths.

GROUND LEVEL

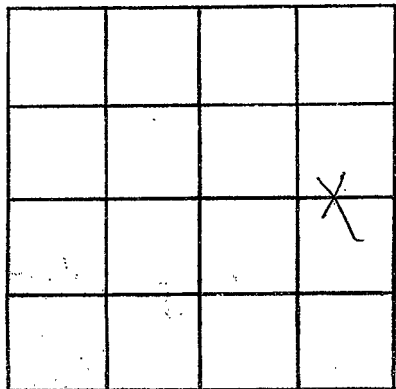

SECTION 8

Please indicate well location X.

ADDITIONAL INFORMATION

If more than one screen,
show locations of each on sketch.