

MISSISSIPPI
BOARD OF WATER COMMISSIONERS
416 North State Street
Jackson, Mississippi 39201

CODED

WATER WELL DRILLERS LOG

WAYNE
K20
6-27-74

JUNE 27, 1974 **McILWAIN WATER WELL SERVICE** **WAYNE**
date well completed RT. firm name BOX 37 county well located

WAYNESBORO, MISS. 39367

LANDOWNER:	description of formations encountered	from	to
CHARLIE JAMES SMITH RT 2 WAYNESBORO, MISS. (mailing address)			
WELL LOCATION: sec. 33 T. 9 N R. 5 W 11 miles E of W'BORO (distance) (direction) (nearest town)	Clay	8	13
WELL PURPOSE: HOME (home, irrigation, municipal, industrial)	Sand	13	17
WELL COMPLETION DATA:	Clay	17	25
(1) diameter (inches) 2"	Coarse Sand	25	53
(2) total depth (feet) 180'	Clay	53	59
(3) static water level (feet) 121' below top of ground.	Blue Clay	59	78
(4) casing PVC , 141' (material) (depth)	Layered Rock	73	95
2" if telescope see back. (size)	Small Brackles	95	139
(5) screen NONE (length) (depth to top)	Blue Clay	139	147
(size) (material)	Rock	142	149
(6) pump 1 1/2 5 (HP) (yield gpm)	Rock	147	149
110 AC (type power)	Brackles + Rocks	149	180
(7) electric log NO (yes or no)			
(organization running log)			
(8) how well bottom plugged			
DRILLERS REMARKS:			


RECEIVED

JUL 15 1974

MISSISSIPPI BOARD OF WATER COMMISSIONERS

If well telescopes please
sketch and show depths.

GROUND LEVEL

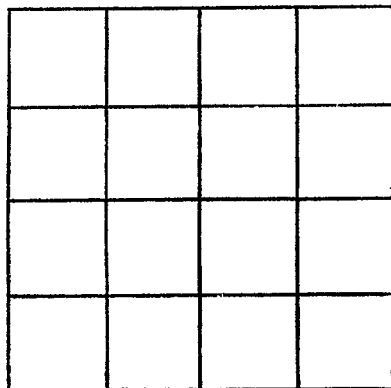

SECTION _____

Please indicate well location X.

ADDITIONAL INFORMATION

If more than one screen,
show locations of each on sketch.