

WAYNE
K21
6-18-74

MISSISSIPPI
 BOARD OF WATER COMMISSIONERS
 416 North State Street
 Jackson, Mississippi 39201

CODED

WATER WELL DRILLERS LOG

JUNE 18, 74 19 **McILWAIN WATER WELL SERVICE** **WAYNE**
 date well completed RT. 4, Box 31 county well located

WAYNESBORO, MISS. 39367


LANDOWNER:	description of formations encountered	from	to
Percy Dozier	Red Clay	0	4
RT 2 Waynesboro, Miss (mailing address)	Red Sand	4	20
WELL LOCATION:	White Sand	20	25
sec. 33 T. 9 N R. 5 W	Clay	25	28
10 miles E of W'boro	Sand	28	38
(distance) (direction) of (nearest town)	Clay	38	45
WELL PURPOSE: HOME (home, irrigation, municipal, industrial)	Blue Clay	45	65
WELL COMPLETION DATA:	Rock	65	66
(1) diameter (inches) 2"	Breaks + Corros	66	85
(2) total depth (feet) 165'	Blue Clay	85	126
(3) static water level (feet) 100' below top of ground.	Rock	126	126 1/2
(4) casing PVC 136' (material) (depth)	Break	126 1/2	129
2" (size) If telescope see back.	Rock	129	131
(5) screen NONE (length) (depth to top)	Break	131	132
(size) (material)	Rock	132	135
(6) pump 1 5 (HP) (yield gpm)	Breaks + Breaks	135	165
110 AC (type power)			
(7) electric log no (yes or no)			
(organization running log)			
(8) how well bottom plugged			
DRILLERS REMARKS:			

RECEIVED

JUL 15 1974

If well telescopes please sketch and show depths.

GROUND LEVEL

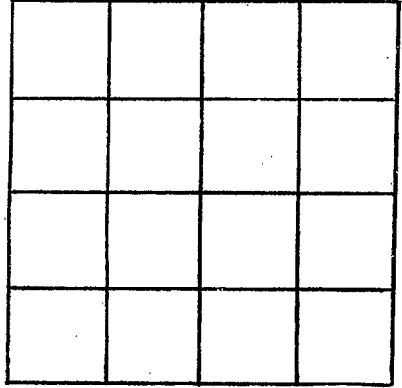

SECTION _____

Please indicate well location X.

ADDITIONAL INFORMATION

If more than one screen, show locations of each on sketch.