

WAYNE
K22
9-21-74

MISSISSIPPI 7
BOARD OF WATER COMMISSIONERS
416 North State Street
Jackson, Mississippi 39201

CODED

WATER WELL DRILLERS LOG

McILWAIN WATER WELL SERVICE

SEPT 21, 1974
date well completed

RT. 2 BOX 37
WAYNESBORO, MISS. 39367

WAYNE
county well located

LANDOWNER:	description of formations encountered	from	to
JOHN EVERETT	Red clay	0	12
RT 2 WAYNESBORO MISS (mailing address)	Chalk	12	18
WELL LOCATION: sec. 33 T 9 N R 5 W 10 miles E of WAYNESBORO (distance) (direction) (nearest town)	Sand	18	33
WELL PURPOSE: HOME (home, irrigation, municipal, industrial)	Clay (yellow)	33	40
WELL COMPLETION DATA:	Blue clay	40	60
(1) diameter (inches) 2"	Rock + internals	60	82
(2) total depth (feet) 150'	Blue clay	82	123
(3) static water level (feet) 91' below top of ground	Rock + internals	123	150
(4) casing PVC, 124' (material) (depth) 2" (size) If telescope see back.			
(5) screen NONE, (length) (depth to top)			
(6) pump 1 (HP) 5 (yield gpm) 110 AC (type power)			
(7) electric log NO (yes or no)			
(8) how well bottom plugged			
DRILLERS REMARKS:			


DISCONTINUED
RIS
12

SEP 25 1974

MISS. BD. OF WATER COMMISSIONERS

If well telescopes please sketch and show depths.

GROUND LEVEL

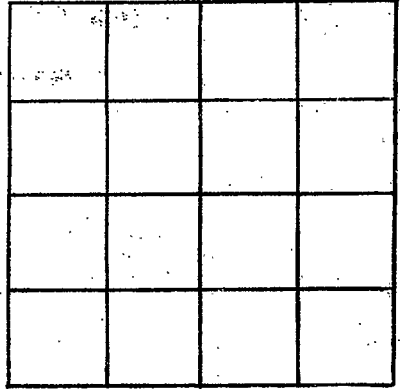

SECTION _____

Please indicate well location X.

ADDITIONAL INFORMATION

If more than one screen, show locations of each on sketch.