

MISSISSIPPI BOARD OF WATER COMMISSIONERS  
416 North State Street  
Jackson, Mississippi 39201

CODED

Wayne Co  
K 24  
8-69

WATER WELL DRILLERS LOG

Aug 9 1969 date well completed  
Porter Drilling & Log. firm name  
Wayne county well located

LANDOWNER: Tom Haskell  
Shirley  
212 Hargreaves Dr  
(mailing address)

description of formations encountered	from	to
red clay	0	10
red sand	10	16
blue chalk	16	45
white sandstone	45	66
blue chalk	66	109
sea shell	109	113
black limestone	113	142
white chalk	142	145

WELL LOCATION:  
sec. 30 T 9 N R 5 E  
9 miles east of Hargreaves  
(distance) (direction) (nearest town)

WELL PURPOSE: none  
(home, irrigation, municipal, industrial)

WELL COMPLETION DATA:

(1) diameter (inches) 2"

(2) total depth (feet) 145'

(3) static water level (feet) 97' below top of ground

(4) casing steel 113' (material) (depth)  
2" (size) if telescope see back.

(5) screen none used (length) (depth to top)  
(size) (material)

(6) pump 1/2 HP 7 1/2 (yield gpm)  
elec. (type power)

(7) electric log none (yes or no)  
(organization running log)

(8) how well bottom plugged open

110' 1 1/2" large pipe


SFP

MISSISSIPPI BOARD OF WATER COMMISSIONERS

DRILLERS REMARKS:

If well telescopes please sketch and show depths.

GROUND LEVEL

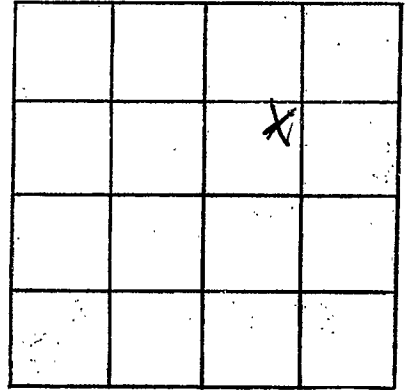

SECTION 32

Please indicate well location X.

ADDITIONAL INFORMATION

If more than one screen, show locations of each on sketch.