

Wayne
K 27
1-6-70

MISSISSIPPI
BOARD OF WATER COMMISSIONERS
416 North State Street
Jackson, Mississippi 39201

CODED
CODED

WATER WELL DRILLERS LOG

Jan 6 1970 Porter Drilling & Supply Wayne
date well completed firm name county well located

LANDOWNER: <u>Jim Walker</u>	description of formations encountered	from	to
<u>Box 2 Haysboro Miss</u> (mailing address)	<u>red clay</u>	<u>0</u>	<u>6</u>
	<u>red sand</u>	<u>6</u>	<u>22</u>
	<u>Chalk</u>	<u>22</u>	<u>30</u>
	<u>red sand</u>	<u>30</u>	<u>60</u>
	<u>sand & chalk</u>	<u>60</u>	<u>70</u>
	<u>clay and sand</u>	<u>70</u>	<u>81</u>
	<u>stone white shell</u>		
	<u>in hand but getting softer</u>		

WELL LOCATION:
sec 33 T 90 N R 5 E
S W
9 miles east of Haysboro
(distance) (direction) (nearest town)

WELL PURPOSE: Home
(home, irrigation, municipal, industrial)

- WELL COMPLETION DATA:
- diameter (inches) 2"
 - total depth (feet) 81
 - static water level (feet) 64 below top of ground.
 - casing steel 75'
(material) (depth)
2" if telescope see back.
(size)
 - screen 5' 76
(length) (depth to top)
1 1/4" 7 shot Johnson SS
(size) (material)
 - pump 1 0
(HP) (yield gpm)
elec
(type power)
 - electric log no
(yes or no)
- (organization running log)
- (8) how well bottom plugged blank point

5' 1 1/4" shot SS with 2'
1 1/2" cap hole in well
Backer
31' 1 1/2" change pipe


JAN 12 1970

MISS. BD. OF
WATER COMM.

DRILLERS REMARKS:

If well telescopes please sketch and show depths.

GROUND LEVEL

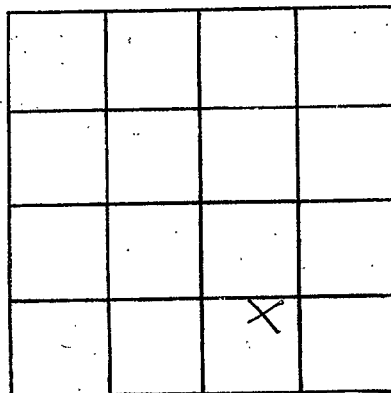

SECTION 33

Please indicate well location X.

ADDITIONAL INFORMATION

If more than one screen, show locations of each on sketch.