

Wayne
K 28
3-3-70

MISSISSIPPI
BOARD OF WATER COMMISSIONERS
416 North State Street
Jackson, Mississippi 39201

WATER WELL DRILLERS LOG

March 3 1970 Porter Drilling Co. Wayne
date well completed firm name county well located

LANDOWNER: Rev. Block Methodist Church
At 2 Magnolia Ave. Miss
(mailing address)

WELL LOCATION:
sec. 17 T. 9 N R. 5 E
10 miles NE of Waynesboro
(distance) (direction) (nearest town)

WELL PURPOSE: church
(home, irrigation, municipal, industrial)

- WELL COMPLETION DATA:
- (1) diameter (inches) 2"
 - (2) total depth (feet) 125
 - (3) static water level (feet) 103 ^{below}/_{above} top of ground.
 - (4) casing steel 116'
(material) (depth)
2" if telescope see back.
(size)
 - (5) screen 11 114"
(length) (depth to top)
1 1/2" 80% S.S.
(size) (material)
 - (6) pump 2 8 1/2
(HP) (yield gpm)
elec
(type power)
 - (7) electric log no
(yes or no)

(organization running log)
 - (8) how well bottom plugged
plug cement


description of formations encountered	from	to
red clay & sand	0	20
chalk	20	35
soft rock	35	45
chalk limestone 53'	45	63
Vicksburg rock	63	86
blue clay 68'		
white chalk & shale	86	107
blue clay 107		
chalk & sand	107	112
sand	112	124
chalk	124	125
70' 4" surface casing		
11' 90 ga S.S. tubing with packer		
110' 1 1/2" drop pipe		

DRILLERS REMARKS:

MAR 19 1970

If well telescopes please sketch and show depths.

GROUND LEVEL

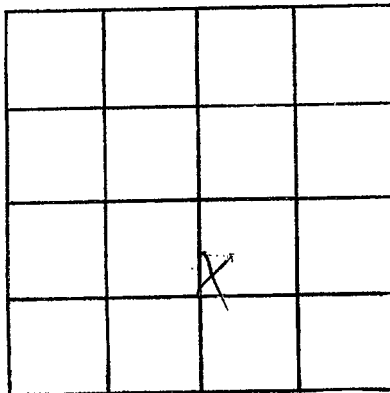

SECTION 17

Please indicate well location X.

ADDITIONAL INFORMATION

If more than one screen,
show locations of each on sketch.