

Wayne
K 29
6-23-70

MISSISSIPPI
BOARD OF WATER COMMISSIONERS
416 North State Street
Jackson, Mississippi 39201

CODED

WATER WELL DRILLERS LOG

6-23 1970 date well completed
Crisis water well service firm name
WAYNE county well located

LANDOWNER: CECIL COLMAN

description of formations encountered from to

(mailing address)

WELL LOCATION:

sec 33 T 9 N R 5 E
9 1/2 miles EAST of WAYNESBORO
(distance) (direction) (nearest town)

WELL PURPOSE: Home
(home, irrigation, municipal, industrial)

WELL COMPLETION DATA:

- (1) diameter (inches) 5" X 2"
- (2) total depth (feet) 110'
- (3) static water level (feet) 77 (below/above top of ground)
- (4) casing 5/8" GALV 105' (material) (depth)
If telescope see back.
(size)
- (5) screen 5" 105' (length) (depth to top)
2" STAIN LESS STEEL (size) (material)
- (6) pump 1 6 (HP) (yield gpm)
ELECT (type power)
- (7) electric log NO (yes or no)

(organization running log)

(8) how well bottom plugged 2"
BACK WASH VALVE

DRILLERS REMARKS: RAN 3"
PROCTIVE CSg TO 93'


description of formations encountered	from	to
Red SAND & CLAY	0	5
PINK & Red CLAY	5	13
PINK & GRAYISH CLAY	13	18
FINE yellow SAND	18	20
PINK & white CLAY	20	30
FINE yellowish SAND	30	35
Med yellowish SAND	35	42
CoARSE yellowish SAND	42	47
PINK & white CLAY	47	58
FINE PINK SAND	58	60
FINE tight yellow SAND	60	65
Med yellow SAND	65	70
CoARSE yellowish SAND	70	77
Med yellowish SAND	77	82
Med yellowish tight SAND	82	92
FINE white SAND	92	95
Med white SAND	95	99
CoARSE yellowish & white SAND	99	110

CODED

JUL 2 1970
MISS. DIV. OF
WATER COMM.

If well telescopes please sketch and show depths.

GROUND LEVEL

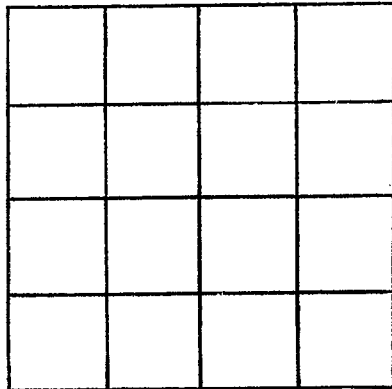

SECTION _____

Please indicate well location X.

ADDITIONAL INFORMATION

If more than one screen,
show locations of each on sketch.