

Wayne
K 30
6-29-70

MISSISSIPPI
BOARD OF WATER COMMISSIONERS
416 North State Street
Jackson, Mississippi 39201

CODED

WATER WELL DRILLERS LOG

6-29 1970 CARAS Well Service WAYNE
date well completed firm name county well located

LANDOWNER CLARENCE PAUG
WANNESBORO MISS
(mailing address)
WELL LOCATION:
sec. 5 T 9 N R. 5 E
6 1/4 miles NNE of WANNESBORO
(distance) (direction) (nearest town)

description of formations encountered	from	to
TAP SOIL	0	2
RED SANDY CLAY	2	8
GRABIST & YELLOW CLAY	8	15
WHITE PINK "	15	17
WHITE "	17	22
BROWN ROCK & "WHITE "	22	30
COARSE CRYSTAL SAND	30	42
BROWN ROCK & YELLOW CLAY	42	50
DARK GRAY CLAY	50	51
COARSE CRYSTAL SAND	51	57
YELLOW CLAY WT. B. P.	57	59
COARSE WHITE SAND	59	67
W. B. G.		

WELL PURPOSE: HOME
(home, irrigation, municipal, industrial)

WELL COMPLETION DATA:
(1) diameter (inches) 4" x 2"
(2) total depth (feet) 67
(3) static water level (feet) 50 below
top of ground. obs.
(4) casing galv., 63
(material) (depth)
(size) If telescope see back.
(5) screen 4', 63'
(length) (depth to top)
2', PLASTIC 10 SLOT
(size) (material)
(6) pump 1 3 1/2
(HP) (yield gpm)
(type power)
(7) electric log _____
(yes or no)
(organization running log)
(8) how well bottom plugged 2' B. W. V.

CODED


JUL 2 1970

DRILLERS REMARKS:

MISS. BD. OF
WATER COMMISSIONERS

If well telescopes please sketch and show depths.

GROUND LEVEL

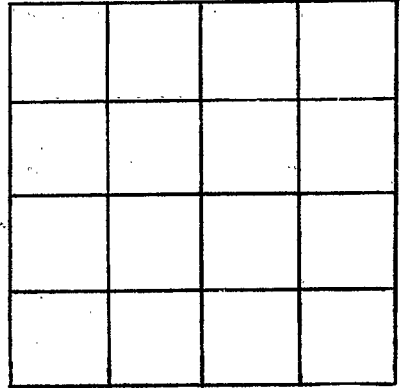

SECTION _____

Please indicate well location X.

ADDITIONAL INFORMATION

If more than one screen,
show locations of each on sketch.