

MISSISSIPPI
BOARD OF WATER COMMISSIONERS
416 North State Street
Jackson, Mississippi 39201

CODED

WATER WELL DRILLERS LOG

Wayne
K31
7-24-70

July 24 1970 date well completed
Port Drilling & Supply firm name
Wayne county well located

LANDOWNER: <u>Doug Walker</u>	description of formations encountered	from	to
At 2 Waynesboro Miss. (mailing address)	sand	0	10
	Chalk	10	15
WELL LOCATION: sec. <u>20</u> T <u>90</u> N R <u>5</u> <u>11</u> miles East of Waynesboro (distance) (direction) (nearest town)	sand	15	39
	blue chalk	39	55
WELL PURPOSE: <u>Home</u> (home, irrigation, municipal, industrial)	rock strata	55	65
	blue chalk	65	84
WELL COMPLETION DATA: (1) diameter (inches) <u>2"</u>	rock	84	85
	blue chalk	85	109
(2) total depth (feet) <u>357'</u>	Unkelpung Honeycomb	109	139
(3) static water level (feet) <u>121</u> (below/above top of ground)	white chalk & rock	139	163
(4) casing <u>steel</u> <u>328</u> (material) (depth)	blue chalk	163	302
<u>2"</u> (size) if telescope see back.	rock strata	302	329
(5) screen <u>10'</u> <u>329</u> (length) (depth to top)	red sandstone	328	
<u>1 1/4"</u> (size) <u>80 ga. S.S.</u> (material)	sand line	329	357
(6) pump <u>2</u> (HP) <u>6</u> (yield gpm)	stagnant on chalk		
<u>elec</u> (type power)			
(7) electric log <u>no</u> (yes or no)			
(organization running log)			
(8) how well bottom plugged <u>plugged gravel</u>			
DRILLERS REMARKS:			


CODED

AUG 13 1970

MISS. BD. OF
WATER COMM.

If well telescopes please sketch and show depths.

GROUND LEVEL

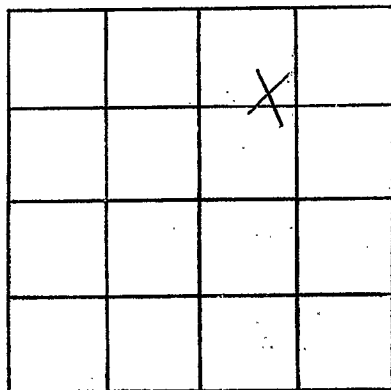

SECTION 28

Please indicate well location X.

ADDITIONAL INFORMATION

If more than one screen,
show locations of each on sketch.