

CODED

Wayne
K 330
5-21-75

MISSISSIPPI
BOARD OF WATER COMMISSIONERS
416 North State Street
Jackson, Mississippi 39201

WATER WELL DRILLERS LOG

MAY 21, 1975¹⁹ date well completed
McILWAIN WATER WELL SERVICE Wayne
RT. # from name BOX 37
WAYNESBORO, MISS 39367 county well located

LANDOWNER:
MR. NEAL WALKER
Rt 2 WAYNESBORO, Miss.
(mailing address)

description of formations encountered	from	to
Red Clay	0	8
Red Sand	8	15
Coarse sand with some clay	15	53
Blue Clay	53	70
Rocks + limy clay	70	85
Clay	85	129
Honey comb		
Rock	129	160

WELL LOCATION:
sec. 28 T 9 N R 5 E 13 P
10 miles NE of W'BORO
(distance) (direction) (nearest town)

WELL PURPOSE: HOME
(home, irrigation, municipal, industrial)

- WELL COMPLETION DATA:
- (1) diameter (inches) 2"
 - (2) total depth (feet) 160'
 - (3) static water level (feet) 110' below top of ground.
 - (4) casing PVC 138'
(material) (depth)
2" If telescope see back.
(size)
 - (5) screen NONE
(length) (depth to top)
 - (6) pump 2 4.5
(HP) (yield gpm)
220 AC
(type power)
 - (7) electric log No
(yes or no)
 - (organization running log)
 - (8) how well bottom plugged


DRILLERS REMARKS:

DRILLERS
MAY 22 1975

MISS. Bd. OF WATER COMMISSIONERS

If well telescopes please sketch and show depths.

GROUND LEVEL

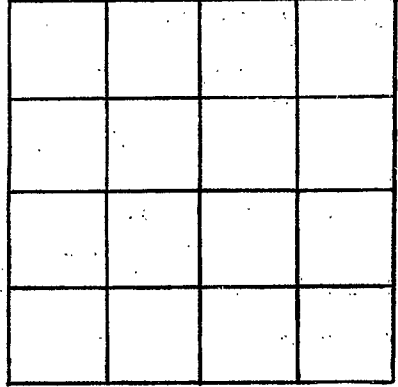

SECTION _____

Please indicate well location X.

ADDITIONAL INFORMATION

If more than one screen, show locations of each on sketch.