

CODED

Wayne
K 34
6-6-75

MISSISSIPPI
BOARD OF WATER COMMISSIONERS
416 North State Street
Jackson, Mississippi 39201

WATER WELL DRILLERS LOG

McILWAIN WATER WELL SERVICE

June 6, 1975
date well completed

RT. 2, BOX 37
WAYNESBORO, MISS. 39367

Wayne
county well located


LANDOWNER:	description of formations encountered	from	to
Mr. J. W. Wells Rt 2 Waynesboro, Miss. (mailing address)			
WELL LOCATION:	Clay	10	15
sec. 30 T. 9 N R. 5 E 13P	Sand	15	19
10 miles NE of W'BORO	Clay + Sand	19	29
(distance) (direction) (nearest town)	Coarse Sand	29	34
WELL PURPOSE: HOME			
(home, irrigation, municipal, industrial)			
WELL COMPLETION DATA:			
(1) diameter (inches) 2"			
(2) total depth (feet) 34'			
(3) static water level (feet) 14' below top of ground.			
(4) casing PVC 29' (material) (depth)			
2" (size) If telescope see back.			
(5) screen 5' 29' (length) (depth to top)			
2" PVC .008 (size) (material)			
(6) pump 3/4 12 (HP) (yield gpm)			
220 AC (type power)			
(7) electric log NO (yes or no)			
(organization running log)			
(8) how well bottom plugged			
DRILLERS REMARKS:			

RECEIVED
JUN 12 1975

MISS. BD. OF WATER COMMISSIONERS

If well telescopes please sketch and show depths.

GROUND LEVEL

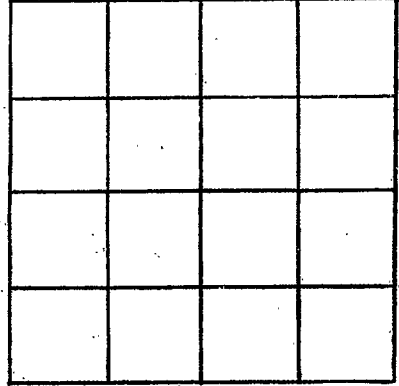

SECTION _____

Please indicate well location X.

ADDITIONAL INFORMATION

If more than one screen, show locations of each on sketch.