

K38  
Wayne Co  
1-8-85

MISSISSIPPI  
BOARD OF WATER COMMISSIONERS  
416 North State Street  
Jackson, Mississippi 39201

CODED  
CODED

WATER WELL DRILLERS LOG

Feb. 8 1985  
date well completed

A-1 Drilling Co., Inc. Wayne  
firm name county well located

LANDOWNER: J. R. Gardner

Route 2, Box 59  
Waynesboro Mo. 39376  
(mailing address)

WELL LOCATION:

sec. 33 T. 9 N R. 5 E  
W  
11 miles E of Waynesboro  
(distance) (direction) (nearest town)

WELL PURPOSE: home  
(home, irrigation, municipal, industrial)

WELL COMPLETION DATA:


- (1) diameter (inches) 2"
- (2) total depth (feet) 105'
- (3) static water level (feet) 71' below top of ground.
- (4) casing PVC 95' (material) (depth)  
2" (size) If telescope see back.
- (5) screen 5' 95' (length) (depth to top)  
2" Stainless Steel (size) (material) .006
- (6) pump 1 (HP) 6 (yield gpm)  
230V 1 ph. (type power)
- (7) electric log no (yes or no)

(organization running log)

(8) how well bottom plugged BWW  
on 5' slinger w/ steel ball

DRILLERS REMARKS:


description of formations encountered	from	to
top soil	0	1
red sandy clay	1	13
sand	13	21
white clay w/ pink sh	21	29
sand	29	72
sand and fine gravel sh	72	90
sand and peb gravel	90	104
lenses of fine yellow sand		
limestone	104	104 1/2
clay	104 1/2	106

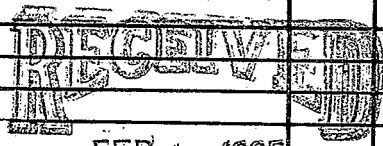

FEB 12 1985

If well telescopes please sketch and show depths.

GROUND LEVEL

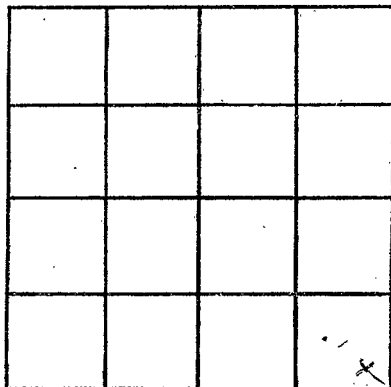

SECTION 33

Please indicate well location X.

ADDITIONAL INFORMATION

If more than one screen,  
show locations of each on sketch.