

WAYNE
K 200
1-7-76

BOA

needs to be completed RS

13P

JAN 7, 1976

McILWAIN WATER WELL SERVICE

Wayne

date well completed

RT. 2 BOX 37

county well located

WAYNESBORO, MISS. 39367

LANDOWNER:

LOONIE WALKER

description of formations encountered

from

to

RT 2 WAYNESBORO, MISS.
(mailing address)

Red Clay 0 12

WELL LOCATION:

sec. 28 T. 9 N R. 5 E

10 miles E of W'BORE
(distance) (direction) (nearest town)

Coarse Red sand 12 20

Sand, some clay 20 28

Yellow clay 28 35

Blue clay 35 50

WELL PURPOSE: HOME
(home, irrigation, municipal, industrial)

Limy rock & clay 50 70

WELL COMPLETION DATA:

Brown clay 70 112

(1) diameter (inches) 4x2

(2) total depth (feet) 140'

(3) static water level (feet) 89' below top of ground.

(4) casing PVC 4" - 37' (material) (depth)

Honey Comb Rock 112 140

(size) if telescope see back.

(5) screen NONE (length) (depth to top)

(size) (material)

(6) pump 1 (HP) 4 (yield gpm)

220 AC (type power)

(7) electric log no (yes or no)

(organization running log)

(8) how well bottom plugged

DRILLERS REMARKS:


RECEIVED
JAN 26 1976

JAN 26 1976

MISS. BD. OF WATER COMM

If well telescopes please sketch and show depths.

GROUND LEVEL

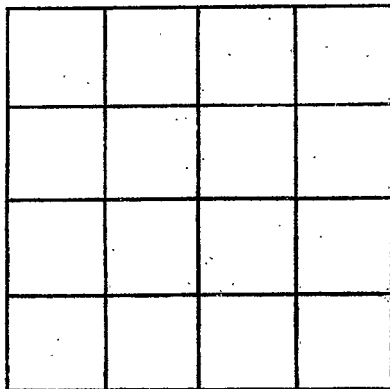

SECTION _____

Please indicate well location X.

ADDITIONAL INFORMATION

If more than one screen, show locations of each on sketch.