

Wayne
K 2003
4-19-76

MISSISSIPPI
BOARD OF WATER COMMISSIONERS
416 North State Street
Jackson, Mississippi 39201

WATER WELL DRILLERS LOG


April 19 1976 Porter Drilling & Log Wayne
date well completed firm name county well located

LANDOWNER: <u>Brandt Miss</u>	description of formations encountered	from	to
<u>P.O. Box 165</u>			
<u>Waynesboro Miss</u> (mailing address)	<u>top of rock</u>	<u>0</u>	<u>14</u>
WELL LOCATION: sec <u>27 T 9 N</u> 2 R <u>5 E</u> <u>10</u> miles <u>NE</u> of <u>Waynesboro</u> (distance) (direction) (nearest town)			
WELL PURPOSE: <u>Home</u> (home, irrigation, municipal, industrial)			
WELL COMPLETION DATA: (1) diameter (inches) <u>2</u> (2) total depth (feet) <u>111'</u> (3) static water level (feet) <u>38</u> below above top of ground. (4) casing <u>P.V.C.</u> <u>41'</u> (material) (depth) <u>2</u> If telescope see back. (size) (5) screen <u>3'</u> <u>41'</u> (length) (depth to top) <u>1/2"</u> <u>6-1/2 SS.</u> (size) (material) (6) pump <u>1</u> <u>10</u> (HP) (yield gpm) <u>elec.</u> (type power) (7) electric log <u>no</u> (yes or no) <u>(organization running log)</u> (8) how well bottom plugged <u>frack and seal</u>			
DRILLERS REMARKS:			

DEPT. OF WATER RESOURCES
MAY 9 1976
MISS. BD. OF WATER

If well telescopes please sketch and show depths.

GROUND LEVEL

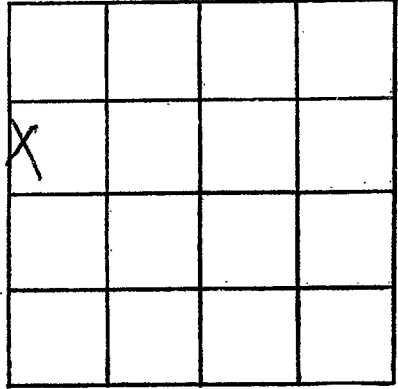

SECTION 27

Please indicate well location X.

ADDITIONAL INFORMATION

If more than one screen,
show locations of each on sketch.