

C. P. CLARK

MISSISSIPPI WATER WELL DRILLING
BOARD OF WATER COMMISSIONERS ROUTE 2
416 North State Street LAUREL, MISS. 39440
13P Jackson, Mississippi 39201

WAYNE
K 2005
7-2-76

WATER WELL DRILLERS LOG

7/2 1976
date well completed

C. P. Clark
firm name

Wayne
county well located


LANDOWNER: <u>Benny Maynard</u>	description of formations encountered	from	to
<u>Rt 5 Box 24</u>			
<u>Waynesboro Miss</u> (mailing address)	<u>Red Clay</u>	<u>0</u>	<u>8</u>
	<u>Red Sand</u>	<u>8</u>	<u>12</u>
	<u>Clay</u>	<u>12</u>	<u>46</u>
	<u>Sand</u>	<u>46</u>	<u>51</u>
	<u>Clay</u>	<u>51</u>	<u>205</u>
	<u>Sandy Clay</u>	<u>205</u>	<u>218</u>
	<u>Rocky Sand</u>	<u>218</u>	<u>219</u>
	<u>Sand</u>	<u>219</u>	<u>243</u>
WELL LOCATION: sec. <u>8</u> T. <u>9N</u> S. R. <u>15E</u> W.			
<u>10</u> miles <u>NE</u> of <u>Waynesboro</u> (distance) (direction) (nearest town)			
WELL PURPOSE: <u>Home</u> (home, irrigation, municipal, industrial)			
WELL COMPLETION DATA:			
(1) diameter (inches) <u>2</u>			
(2) total depth (feet) <u>243</u>			
(3) static water level (feet) <u>132</u> below above top of ground.			
(4) casing <u>Galvalume</u> <u>231</u> (material) (depth)			
(size) if telescope see back.			
(5) screen <u>12</u> <u>231</u> (length) (depth to top)			
<u>1 1/4</u> <u>Gauge 5.5 6bt #60</u> (size) (material) <u>6bt #60</u>			
(6) pump <u>1 1/2</u> <u>5</u> (HP) (yield gpm)			
<u>2200 S.P.</u> (type power)			
(7) electric log <u>No</u> (yes or no)			
(organization running log)			
(8) how well bottom plugged <u>Bw u</u>			
DRILLERS REMARKS: <u>Set Jet</u> <u>@ 147 with depth</u> <u>7. m jet</u>			

RECEIVED
JUL 12 1976

MISS. Bd. OF WATER COMMISSIONERS

If well telescopes please sketch and show depths.

GROUND LEVEL

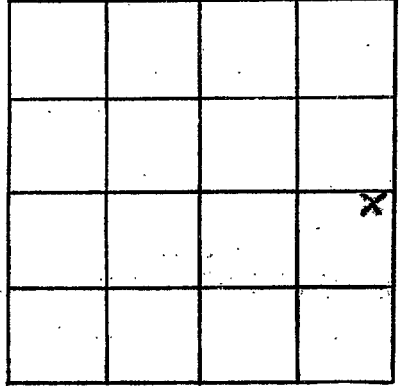

SECTION 8

Please indicate well location X.

ADDITIONAL INFORMATION

If more than one screen, show locations of each on sketch.