

Wayne
 R. 2000
 7/24/76

MISSISSIPPI
 BOARD OF WATER COMMISSIONERS
 416 North State Street
 Jackson, Mississippi 39201

WATER WELL DRILLERS LOG

July 24, 1976^{13P} date well completed
 McILWAIN WATER WELL SERVICE WAYNE
 RT. 2, BOX 37 county well located
 WAYNESBORO, MISS. 39367

LANDOWNER:
 L.C. Smith
 RT 2 WAYNESBORO, Miss.
 (mailing address)

WELL LOCATION:
 sec. 19 T 9 N R 5 E
 10 miles NE of W'BORO
 (distance) (direction) (nearest town)

WELL PURPOSE: HOME
 (home, irrigation, municipal, industrial)

WELL COMPLETION DATA:
 (1) diameter (inches) 4" x 2"
 (2) total depth (feet) 155'
 (3) static water level (feet) 112' below top of ground.
 (4) casing 4" = 52' PVC (material) (depth)
 (size) If telescope see back.
 (5) screen 6" 149' (length) (depth to top)
 1/4" SS GAUZE (size) (material)
 (6) pump 1/2 HP 6 (yield gpm)
 220 AC (type power)
 (7) electric log no (yes or no)
 (organization running log)
 (8) how well bottom plugged


description of formations encountered	from	to
Red Clay	0	8
Coarse sand + pea gravel	8	17
Clay	18	26
Sand	20	30
Clay	30	35
Blue clay	35	52
Rocks + clay	52	75
Clay	75	95
Rock	95	145
Sand	145	155

RECEIVED
 AUG 1 8 1976

DRILLERS REMARKS:

If well telescopes please sketch and show depths.

GROUND LEVEL

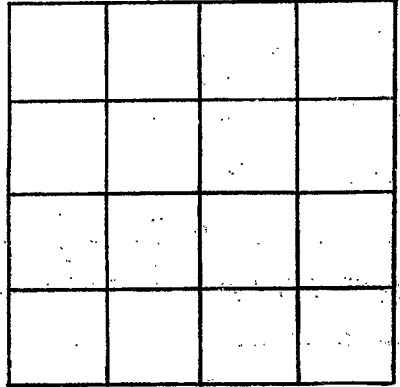

SECTION _____

Please indicate well location X.

ADDITIONAL INFORMATION

If more than one screen, show locations of each on sketch.