

MISSISSIPPI
BOARD OF WATER COMMISSIONERS
416 North State Street
Jackson, Mississippi 39201

WATER WELL DRILLERS LOG

Wayne
R 2007
9/30/76

13P

Sept 30 1976 *Roy V. Wet* water wells *Wayne*
date well completed firm name county well located


LANDOWNER: <i>McKernon</i>	description of formations encountered	from	to
<i>Rt 4 waynesboro</i>	<i>Sandy Clay</i>	<i>0</i>	<i>16</i>
	<i>Blue Clay</i>	<i>16</i>	<i>206</i>
	<i>Road</i>	<i>200</i>	<i>227</i>
(mailing address)			
WELL LOCATION: <i>5</i>			
sec. <i>8</i> T. <i>9</i> N. R. <i>17</i> E. <i>W</i>			
<i>12</i> miles <i>NE</i> of <i>Waynesboro</i>			
(distance) (direction) (nearest town)			
WELL PURPOSE: <i>home</i>			
(home, irrigation, municipal, industrial)			
WELL COMPLETION DATA:			
(1) diameter (inches) <i>2</i>			
(2) total depth (feet) <i>227</i>			
(3) static water level (feet) <i>100</i> below/above top of ground.			
(4) casing <i>galv</i> , <i>227</i> , (material) (depth)			
(size) If telescope see back.			
(5) screen <i>10</i> , <i>217</i> (length) (depth to top)			
<i>1/2</i> , <i>St steel</i> (size) (material)			
(6) pump <i>1 1/2</i> , <i>7</i> (HP) (yield gpm)			
<i>Rea</i> (type power)			
(7) electric log <i>No</i> (yes or no)			
(organization running log)			
(8) how well bottom plugged <i>wash valve</i>			
DRILLERS REMARKS:			

RECEIVED
OCT 14 1976

MISS. BD. OF WATER COMES

If well telescopes please sketch and show depths.

GROUND LEVEL

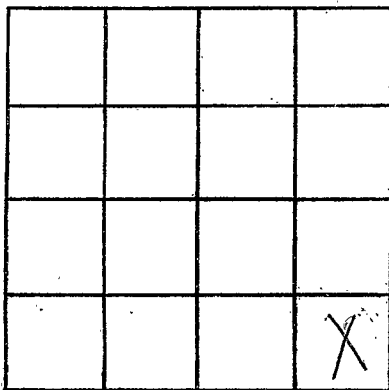

SECTION 8

Please indicate well location X.

ADDITIONAL INFORMATION

If more than one screen, show locations of each on sketch.