

WAYNE

K 2009

12-1-77

MISSISSIPPI
 BOARD OF WATER COMMISSIONERS
 416 North State Street
 Jackson, Mississippi 39201

WATER WELL DRILLERS LOG
 McILWAIN WATER WELL SERVICE

Dec 1
 date well completed

19 77 RT. 2, BOX 37
 WAYNESBORO, MISS. 39367

Wayne
 county well located


LANDOWNER:	description of formations encountered	from	to
Cleveland Smith	Red Clay	0	10
Waynesboro Miss. (mailing address)	RED SAND & CLAY	10	15
WELL LOCATION: sec. 34 T. 9 N R. 18 E 10 miles NE of W'boro (distance) (direction) (nearest town)	SAND	15	70
WELL PURPOSE: HOME (home, irrigation, municipal, industrial)			
WELL COMPLETION DATA: (1) diameter (inches) 2" (2) total depth (feet) 70' (3) static water level (feet) 47' below top of ground (4) casing PVC 65' (material) (depth) 2" (size) if telescope see back. (5) screen 5' 65' (length) (depth to top) 2" PVC .008 (size) (material) (6) pump 3/4 6 (HP) (yield gpm) 110 AC (type power) (7) electric log No (yes or no) (organization running log) (8) how well bottom plugged			
DRILLERS REMARKS:			

RECEIVED
 APR 24 1978

MISS. BD. OF WATER COMMISSIONERS

If well telescopes please
sketch and show depths.

GROUND LEVEL

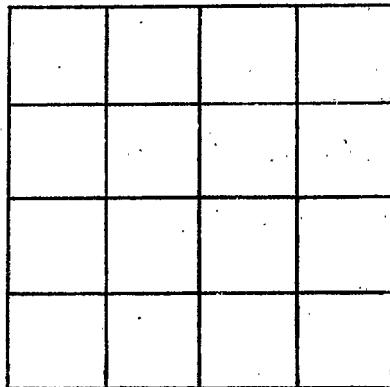

SECTION _____

Please indicate well location X.

ADDITIONAL INFORMATION

If more than one screen,
show locations of each on sketch.