

WAYNE
K 2010
1-13-79

**MISSISSIPPI  
BOARD OF WATER COMMISSIONERS**  
416 North State Street  
Jackson, Mississippi 39201

**WATER WELL DRILLERS LOG**

JAN 13 1979 McILWAIN WATER WELL SERVICE WAYNE  
 date well completed firm name county well located  
 RT. 2, BOX 37

LANDOWNER: WAYNESBORO, MISS. 39367  
FRED JONES  
Waynesboro Ms (mailing address)  
 WELL LOCATION: sec. 34 T. 9 N R. 18 E  
13 miles E of W'bord  
 (distance) (direction) (nearest town)

description of formations encountered	from	to
<u>Red Clay</u>	<u>0</u>	<u>5</u>
<u>Clay &amp; Sand Rock</u>	<u>5</u>	<u>15</u>
<u>COARSE SAND</u>	<u>15</u>	<u>53</u>

WELL PURPOSE: Home  
 (home, irrigation, municipal, industrial)

WELL COMPLETION DATA:

(1) diameter (inches) 2"

(2) total depth (feet) 53'

(3) static water level (feet) 34' below above top of ground.

(4) casing PVC 48'  
 (material) (depth)  
2' if telescope see back.  
 (size)

(5) screen 5' 48'  
 (length) (depth to top)  
2" PVC 200's  
 (size) (material)

(6) pump 1 12  
 (HP) (yield gpm)  
220 AC  
 (type power)

(7) electric log No  
 (yes or no)

(organization running log)

(8) how well bottom plugged

Miss. Board of Water Comm.


MAR 5 1979

DRILLERS REMARKS:

**RECEIVED**

If well telescopes please sketch and show depths.

GROUND LEVEL

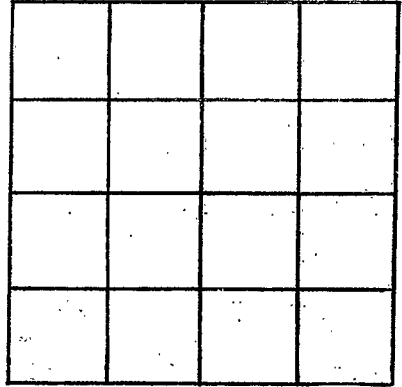

SECTION \_\_\_\_\_

Please indicate well location X.

ADDITIONAL INFORMATION

If more than one screen,  
show locations of each on sketch.