

WAYNE
K 2011
1-09-79

**MISSISSIPPI
BOARD OF WATER COMMISSIONERS**
416 North State Street
Jackson, Mississippi 39201

WATER WELL DRILLERS LOG

Jan 9 1979 Center Drillers & Log Wayne
 date well completed firm name county well located

LANDOWNER Brundage Cross
P.O. Box 165
Waynesboro Miss
 (mailing address)

WELL LOCATION:
 sec 27 T 9 N R 5 E
9 miles east of Waynesboro
 (distance) (direction) (nearest town)

WELL PURPOSE: Drinking
 (home, irrigation, municipal, industrial)

WELL COMPLETION DATA:

(1) diameter (inches) 2"

(2) total depth (feet) 340'

(3) static water level (feet) 120' below top of ground.

(4) casing steel 329'
 (material) (depth)
2" if telescope see back.
 (size)

(5) screen 10' 329'
 (length) (depth to top)
2" galv. ss
 (size) (material)

(6) pump 2 5
 (HP) (yield gpm)
elec
 (type power)

(7) electric log no
 (yes or no)

(organization running log)

(8) how well bottom plugged 2' back with valve

description of formations encountered	from	to
sand & clay	0	12
clay	12	59
shales	59	70
clay	70	114
limestone	114	146
white clay	146	172
blue clay	172	306
red shales	306	326
fine sand	326	332
hard fine sand	332	335
clay	335	336
fine sand	336	339
clay	339	340

147' 1 1/4 galv. drop pipe

Miss. Board of Water Comm.


FEB 8 1979

RECEIVED

DRILLERS REMARKS:

If well telescopes please sketch and show depths.

GROUND LEVEL

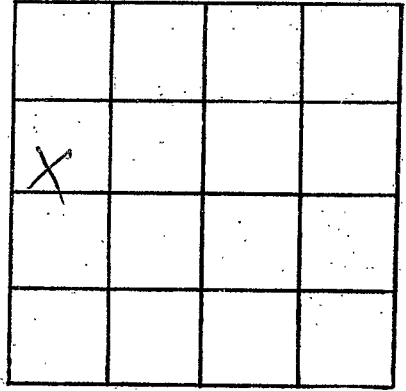

SECTION 27

Please indicate well location X.

ADDITIONAL INFORMATION

If more than one screen,
show locations of each on sketch.