

WAYNE
K 2012
6-28-79

**MISSISSIPPI
BOARD OF WATER COMMISSIONERS**
416 North State Street
Jackson, Mississippi 39201

WATER WELL DRILLERS LOG

6-28 1979 date well completed McILWAIN WATER WELL SERVICE Wayne RT firm name BDX 3/1 Wayne county well located
WAYNESBORO MISS. 39367

LANDOWNER:	description of formations encountered	from	to
BEN Holston	RED SAND + Clay	0	20
Waynesboro Miss (mailing address)	White SAND	20	24
WELL LOCATION:	White Clay	24	33
sec 33 T 9 N R 18 E	Med. Fine SAND	33	41
11 miles E of Wboro	White Clay	41	46
(distance) (direction) (nearest town)	SAND	46	48
WELL PURPOSE: Home	Mixed Clay →	48	57
(home, irrigation, municipal, industrial)	SAND + Clay	57	68
WELL COMPLETION DATA:	COARSE SAND	68	72
(1) diameter (inches) 2"	Med - COARSE SAND	72	83
(2) total depth (feet) 83'			
(3) static water level (feet) 57' below top of ground.			
(4) casing PVC 78' (material) (depth)			
2" If telescope see back. (size)			
(5) screen 5' 78' (length) (depth to top)			
2" PVC .008 (size) (material)			
(6) pump 1 6 (HP) (yield gpm)			
220 AC (type power)			
(7) electric log NO (yes or no)			
(organization running log)			
(8) how well bottom plugged			

Miss. Board of Water Comm.


AUG 9 1979

RECEIVED

DRILLERS REMARKS:

If well telescopes please sketch and show depths.

GROUND LEVEL

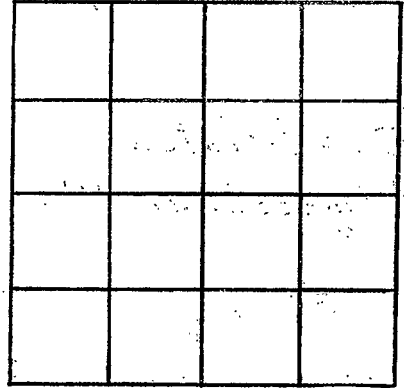

SECTION _____

Please indicate well location X.

ADDITIONAL INFORMATION

If more than one screen,
show locations of each on sketch.