

MISSISSIPPI DEPARTMENT OF NATURAL RESOURCES

Bureau of Land and Water Resources

Southport Mall

P.O. Box 10631

Jackson, Mississippi 39209

WATER WELL DRILLERS LOG

WAYNE  
R 2013  
1/27/81

date well completed Jan 27 19 81 Porter Drilling & Log firm name Wayne county well located

LANDOWNER: Johanny Blasco  
At 2 27 ayneshoro Min.  
(mailing address)

WELL LOCATION:  
sect. 32 T 9 N R 5 E  
7 miles E of Yanceyboro  
(distance) (direction) (nearest town)

WELL PURPOSE: Home  
(home, irrigation, municipal, industrial)

- WELL COMPLETION DATA:
- (1) diameter (inches) 2"
  - (2) total depth (feet) 6.5'
  - (3) static water level (feet) 11 below above  
top of ground.
  - (4) casing steel 36'  
(material) (depth)  
2"  
(size) if telescope see back.
  - (5) screen none used  
(length) (depth to top)  
(size) (material)
  - (6) pump 1 12  
(HP) (yield gpm)  
olee  
(type power)
  - (7) electric log no  
(yes or no)  
(organization running log)
  - (8) how well bottom plugged open

description of formations encountered	depth	
	from	to
<u>clay &amp; sand</u>	<u>0</u>	<u>11</u>
<u>10' sh</u>	<u>11</u>	<u>36</u>
<u>sh</u>	<u>36</u>	<u>37</u>
<u>clay</u>	<u>37</u>	<u>42</u>
<u>shaly sand</u>	<u>42</u>	<u>6.5</u>
<u>21' 1 1/2' galv. pipe</u>		
<u>drop</u>		

DRILLERS REMARKS:


DEPT. OF NATURAL RESOURCES  
BUREAU OF LAND & WATER RESOURCES

MAR - 6 1981

RECEIVED

If well telescopes please sketch and show depths.

GROUND LEVEL

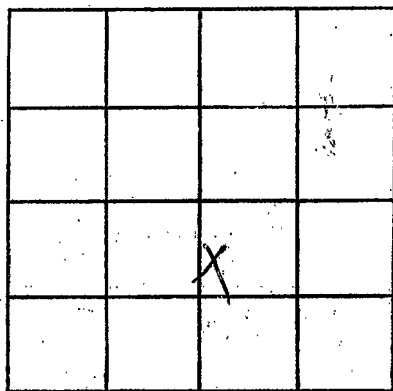

SECTION 32

Please indicate well location X.

ADDITIONAL INFORMATION

If more than one screen, show locations of each on sketch.