

MISSISSIPPI DEPARTMENT OF NATURAL RESOURCES

Bureau of Land and Water Resources

Southport Mall

P.O. Box 10631

Jackson, Mississippi 39209

WATER WELL DRILLERS LOG

WAYNE
K 2014
2/5/81
Feb 5

date well completed 19 81 Porter Drilling & Log firm name Itzinger county well located

LANDOWNER: Troy Skerley
At 2 Itzingerboro, Miss

description of formations encountered	from	to
sand & clay	0	33
clay	33	52
sand	52	

(mailing address)

WELL LOCATION:
sec 32 T 9 N R 5 E
8 miles E of Itzingerboro (distance) (direction) (nearest town)

clay	0	11
rock	11	12
clay	12	22
rock	22	23
clay	23	76
Itzinger rock	76	105

WELL PURPOSE: home (home, irrigation, municipal, industrial)

WELL COMPLETION DATA:

- (1) diameter (inches) 2'
- (2) total depth (feet) 105'
- (3) static water level (feet) 53.3 below top of ground
- (4) casing steel 78' (material) (depth)
2' (size) if telescope see back.
- (5) screen none used (length) (depth to top)
- (6) pump 3/4 (HP) 8 (material) (yield gpm)
elec. (type power)
- (7) electric log no (yes or no)
- (organization running log)
- (8) how well bottom plugged open


DRILLERS REMARKS:

DEPT. OF NATURAL RESOURCES
BUREAU OF LAND & WATER RESOURCES

MAR - 6 1981
RECEIVED

If well telescopes please sketch and show depths.

GROUND LEVEL

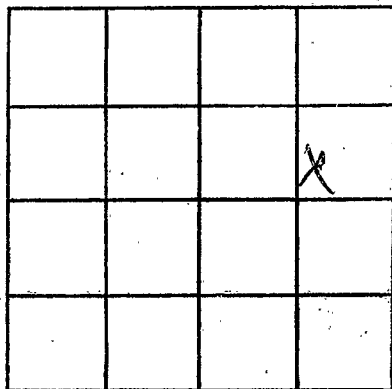

SECTION 32

Please indicate well location X.

ADDITIONAL INFORMATION

If more than one screen,
show locations of each on sketch.