

Wayne
K 3015
8-6-81

MISSISSIPPI
BOARD OF WATER COMMISSIONERS
416 North State Street
Jackson, Mississippi 39201

WATER WELL DRILLERS LOG

8/6 1981 CARB'S WELL SER. WAYNE
date well completed firm name county well located

LANDOWNER: ROBERT DYESS

PT. 4 WAYNESBORO

MS. 39367
(mailing address)

WELL LOCATION:

sec. 27 T. 9 N. R. 5 E. S. W

ABOUT 10 miles E of WAYNESBORO
(distance) (direction) (nearest town)

WELL PURPOSE:

(home) Irrigation, municipal, industrial

WELL COMPLETION DATA:


- (1) diameter (inches) 2"
- (2) total depth (feet) 74'
- (3) static water level (feet) 60 Below above top of ground.
- (4) casing P.V.C. 69' (material) (depth)
2" (size) if telescope see back.
- (5) screen 5' 69' (length) (depth to top)
2" (size) P.V.C. (material)
- (6) pump 1 (HP) 5 (yield gpm)
ELEC (type power)
- (7) electric log NO (yes or no)
(organization running log)
- (8) how well bottom plugged CAPPED

description of formations encountered

from

to


TOP SOIL	0	1
RED SD CLAY	1	15
C. RED SD	15	30
C. WH. "	30	45
M. " "	45	60
C. WH. "	60	74

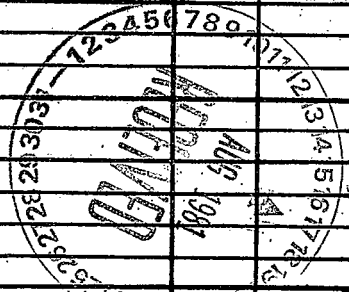

DRILLERS REMARKS:

If well telescopes please sketch and show depths.

GROUND LEVEL

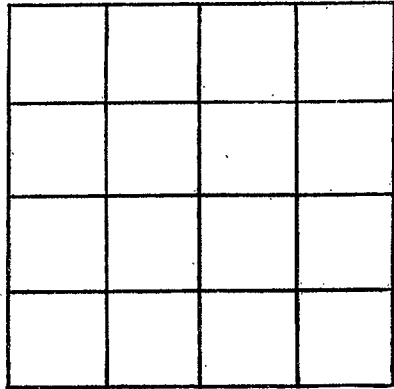

SECTION _____

Please indicate well location X.

ADDITIONAL INFORMATION

If more than one screen,
show locations of each on sketch.