

Wayne
K
K 2018

MISSISSIPPI
BOARD OF WATER COMMISSIONERS
416 North State Street
Jackson, Mississippi 39201

WATER WELL DRILLERS LOG

10-3 1983 Carrs well serv wayne
date well completed firm name county well located

LANDOWNER: DAWN FRANKLIN
waynesboro miss
(mailing address)
WELL LOCATION:
sect 7 T 9 N R 5 E
S W
9 miles E NE of W460
(distance) (direction) (nearest town)

WELL PURPOSE: HOME
(home, irrigation, municipal, industrial)

WELL COMPLETION DATA:
(1) diameter (inches) 2"
(2) total depth (feet) 210
(3) static water level (feet) 80 below above top of ground.
(4) casing PVC 200'
(material) (depth)
(size) If telescope see back.
(5) screen 10' 200'
(length) (depth to top)
2" PVC
(size) (material)
(6) pump 1 7
(HP) (yield gpm)
Elect
(type power)
(7) electric log (yes or no)
(organization running log)
(8) how well bottom plugged PVC CAP


Description of formations encountered	from	to
Top Soil	0	2
Red+CREAMY CLAY	2	8
CREAMY CLAY	8	14
Fine white SD	14	16
GRAY CLAY	16	28
SOFT GRAY CLAY	28	30
GRAY CLAY	30	55
BROWNISH SD	55	56
BROWN-PINK YLW+WHITE	56	64
GRAY CLAY	64	94
HARD Lime Rock	94	95
GRAY CLAY	95	115
Med to HARD Lime Rock	115	117
SOFT Lime Rock	117	118
HARD Lime Rock	118	119
Med Lime Rock	119	120
CREAMY GRAY CLAY	120	124
HARD Lime Rock	124	125
GRAY CLAY	125	130
Last Ret went Blind to 134'		
Med soft CLAY	134	166
Lime Rock	166	172
Med to HD Lime Rock	172	173
Hd Brown Lime Rock	173	175
Lime Rock	175	184
Hd Tight GRAY SD	184	211
Hd Lime Rock	211	212
CREAMY Lime	212	216
Hd Lime Rock	216	218

NOV 23 1983
RECEIVED
DEPT OF NATURAL RESOURCES
BUREAU OF LAND & WATER RESOURCES

DRILLERS REMARKS:

If well telescopes please sketch and show depths.

GROUND LEVEL

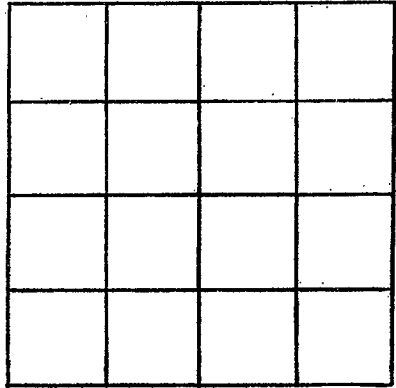

SECTION _____

Please indicate well location X.

ADDITIONAL INFORMATION

If more than one screen,
show locations of each on sketch.