

MISSISSIPPI DEPARTMENT OF NATURAL RESOURCES

Bureau of Land and Water Resources

Southport Mall

P.O. Box 10631

Jackson, Mississippi 39209

WATER WELL DRILLERS LOG

WAYNE
K 5050

3-31-86 date well completed 86 McDonald Hill Ave firm name Wayne county well located

LANDOWNER:
James Graham
Rt. 2, Box 108 E Wayne, Miss
(mailing address)

description of formations encountered	from	to
sand	0	17
sandy	17	60
st limestone	60	70
shale	70	95
st rock	95	100
shale	100	220
#12 sand st rock	220	265

WELL LOCATION:
sec. 3 T. 9 N. R. 7 E. S. 5 W.
10 miles east of Waynesboro
(distance) (direction) (nearest town)

WELL PURPOSE: home
(home, irrigation, municipal, industrial)


- WELL COMPLETION DATA:
- (1) diameter (inches) 4"
 - (2) total depth (feet) 265'
 - (3) static water level (feet) 162' below top of ground.
 - (4) casing 4" pvc pipe (material) 200' (depth)
4" (size) if telescope see back.
 - (5) screen NO (length) (depth to top)
— (size) (material)
 - (6) pump 1/2 (HP) 5 (yield gpm)
E (type power)
 - (7) electric log NO (yes or no)
(organization running log)
 - (8) how well bottom plugged filled

RECEIVED
MAY 2 1986
APR - 9 1986

DRILLERS REMARKS:

If well telescopes please sketch and show depths.

GROUND LEVEL

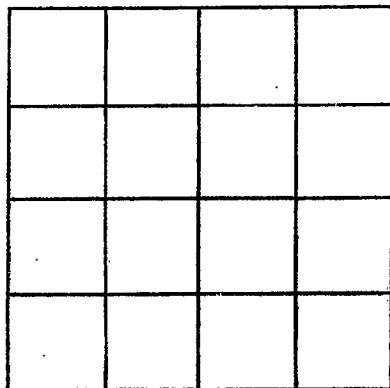

SECTION _____

Please indicate well location X.

ADDITIONAL INFORMATION

If more than one screen, show locations of each on sketch.