

MISSISSIPPI DEPARTMENT OF NATURAL RESOURCES

Bureau of Land and Water Resources

Southport Mall

P.O. Box 10631

Jackson, Mississippi 39209

WATER WELL DRILLERS LOG

Wayne  
K 2001

April 11, 1986 Porter Drilling & Log Wayne  
(date well completed) firm name county well located


LANDOWNER: John Clayton  
P.O. Box 111  
Waynesboro Ms.  
(mailing address)

WELL LOCATION:  
sec 7 T 90 N R 5 E  
S W  
10 miles NE of Waynesboro  
(distance) (direction) (nearest town)

WELL PURPOSE: camp  
(home, irrigation, municipal, industrial)

WELL COMPLETION DATA:  
(1) diameter (inches) 2"  
(2) total depth (feet) 120  
(3) static water level (feet) 33 below above top of ground.  
(4) casing P.V.C. 175'  
(material) (depth)  
2" if telescope see back.  
(size)  
(5) screen 175'  
(length) (depth to top)  
2" bold S.S.  
(size) (material)  
(6) pump none set 20  
(HP) (yield gpm)  
with air  
(type power)  
(7) electric log no  
(yes or no)  
(organization running log)  
(8) how well bottom plugged 2' back wash valve

description of formations encountered	from	to
red clay	0	12
blue silt	12	90
soft red strata	90	100
gray clay	100	142
loose silt	142	159
thin med. clean sand	159	190
stagnant white silt sand		
"corro"		
40' 1 1/2" E 80 P.V.C. dwp pipe		

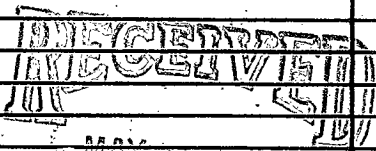


MAY 22 1986

DRILLERS REMARKS:

Department of Natural Resources  
Bureau of Land & Water Resources

If well telescopes please sketch and show depths.

GROUND LEVEL

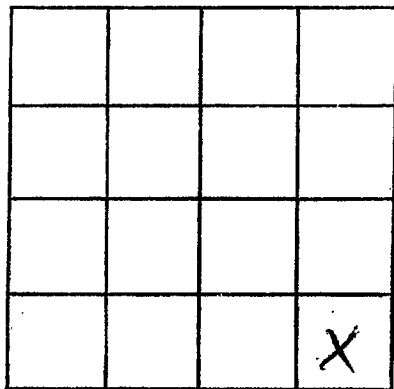

SECTION 7

Please indicate well location X.

ADDITIONAL INFORMATION

If more than one screen,  
show locations of each on sketch.