

# MISSISSIPPI DEPARTMENT OF NATURAL RESOURCES

Bureau of Land and Water Resources

P.O. Box 10631

Jackson, Mississippi 39209

WATER WELL DRILLERS LOG

COUNTY WELL LOCATED <b>WAYNE</b>	
WELL NUMBER <b>K</b>	CODED
DATE WELL COMPLETED <b>7/22/87</b>	

PERMIT NUMBER <b>205</b>
NAME OF DRILLING FIRM <b>CARB'S WELL SER.</b>
<b>BUCKATUNNA, MS.</b>

NAME & MAILING ADDRESS OF LANDOWNER <b>JANICE WALKER</b>			
<b>RT. 2 WAYNESBORO</b>			
<b>MS. 39367</b>			
WELL LOCATION: SEC	TOWNSHIP	RANGE	
<b>27</b>	<b>9 S</b>	<b>5 E</b>	
DISTANCE	DIRECTION	NEAREST TOWN	
<b>10</b> Miles	<b>E</b>	<b>WAYNESBORO</b>	
OTHER LANDMARK <b>ABOUT 1 MI. W. AIA. LINE</b>			
WELL PURPOSE: Home, Irrigation, Municipal, Industrial, Fish Pond, etc.			

PUMP DATA		
PUMP TYPE (Circle One): Submersible, Turbine, <b>Jet</b> Flowing Well, Other (Describe) _____		
POWER TYPE (Circle One): <b>Electric</b> , Tractor, Diesel, Gasoline, Butane, Other (Describe) _____		
Pump Capacity (GPM) <b>12</b>	No. of Stages <b>2</b>	Setting Depth <b>70</b> FT.
PUMP TEST		
Well yielded <b>12</b> GPM with a drawdown of <b>5</b> ft. after <b>1</b> hours of pumping		

WELL DATA		
Well Depth <b>78</b>	Casing Diameter (In.) <b>2'</b>	Casing Length (Ft.) <b>73</b>
Type of Casing <b>PUC</b>	Hole Depth <b>78</b>	Depth to Static Water Level <b>63</b>
TYPE OF COMPLETION: (Circle One or More): Gravel Packed, Underreamed, Telescoped, <b>Natural Development</b> , Open Hole, Other (Describe) _____		
Top of Lap Pipe or Reduction in Casing <b>FEET</b> IF TELESCOPED OR MORE THAN ONE SCREEN: USE BACK PAGE		

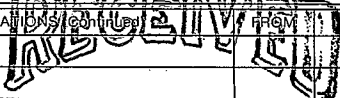
LOG DATA	
TYPE OF LOG RUN (Circle One): No Log Run, Electric, Gamma Ray, Density, Sonic, Neutron, Other (Describe) _____	
Name of Organization Running Log	

SCREEN DATA		
Diameter - Inches <b>2"</b>	Length - Feet <b>5'</b>	Slot Size - Inches <b>8</b>
Screen Type <b>PUC</b>	Depth to Bottom - Feet <b>78</b>	

GEOLOGIC DATA (Office Use Only)			
Surface Elev.	Geologic Unit	Unit Thickness	Depth to Top
Subs. SWL	Date	Analysis	Aquifer Test

Driller's Remarks <b>STOPPED ON CHALK PIVOTED BACK WASH VALVE</b>
------------------------------------------------------------------------------

DESCRIPTION OF FORMATIONS ENCOUNTERED	FROM	TO
<b>TOP SOIL</b>	<b>0</b>	<b>1</b>
<b>RED SANDY CLAY</b>	<b>1</b>	<b>15</b>
<b>LOOSE SAND</b>	<b>15</b>	<b>49</b>
<b>Yellow SAND</b>	<b>49</b>	<b>78</b>

 <b>AUG 10 1987</b>	
Department of Natural Resources Bureau of Land & Water Resources	
IF MORE SPACE IS NEEDED, USE BACK	

If well telescopes please  
sketch and show depths.

GROUND LEVEL


SECTION \_\_\_\_\_

Please indicate well location X.

ADDITIONAL INFORMATION

If more than one screen,  
show location of each on sketch.