

21
9-26-60

WATER WELL DRILLERS LOG

C. P. CLARK

Date: 9/26, 1960, Driller: WATER WELL DRILLING County: Jones

ROUTE TWO
Name
LAUREL, MISS.

- (1) Owner of Land: Mrs. Follie Arrington
(Name)
Waynesboro Rt # 1
(Address)
- (2) Location: NW 1/4, NW 1/4, Sec. 34 8th 9th
T R
1 miles North of Strengthland
(distance) (direction) (Nearest Town)
- (3) Topography: (Hilly) (Flat) (Level)
- (4) Purpose of Well: Domestic
(Domestic Irrigation
Municipal, Industrial, Other)

Description & Color of Materials Sand, Clay, Red Clay, Shell, etc.	Thick- ness Feet	Depth Feet
0-40 Clay	40	
40-55 Sandy Clay	15	
55-160 Clay	105	
160-180 fine Sand	20	

Information upon completion of well:

- (1) Diameter 2 inches.
- (2) Total Depth 180 feet.
- (3) Water Level 14 feet below top of ground.
- (4) Cased to 168, Size 2 in
- (5) Screen: Size 1 1/4, Length 12
- (6) Were any formations sealed against pollution?
yes, no.

If YES depth of formation _____

Why _____

Drillers Remarks: Jet pump


Elev 228±

pH 6.0

Fe in H₂O

Sp. Cond. 90

Temp 68°

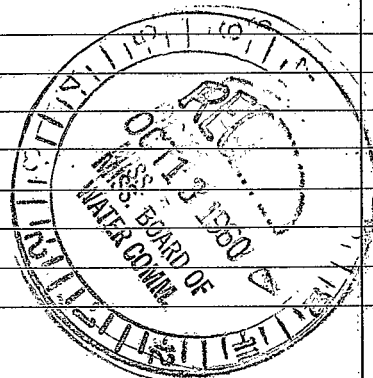

(Use Back Side)

Well No.

