

WAYNE MISSISSIPPI BOARD OF WATER COMMISSIONERS

L7

10-22-64

WATER WELL DRILLERS LOG

Date: Oct 22, 1964, Drilled by Porter Drilling & Log County Wayne
(Name)

(1) Owner of Land: Nelson
(Name)
Rt 1 Waynesboro, Miss
(Address)

(2) Location: SE 1/4, SW 1/4, Sec. 25 T8 R9
2 miles NE of Streightford
(distance) (direction) (Nearest Town)

(3) Topography: hilly
(Hilly) (Flat) (Level)

(4) Purpose of Well: domestic
(Domestic Irrigation, Municipal, Industrial, Other)

Description & Color of Materials Sand, Clay, Red Clay, Shell, etc.	Thick- ness Feet	Depth Feet
<u>red clay & sand</u>	<u>25</u>	<u>25</u>
<u>blue chalk</u>	<u>33</u>	<u>58</u>
<u>fine sandy sand</u>	<u>24</u>	<u>82</u>
<u>small coarse sand</u>	<u>4</u>	<u>86</u>
<u>fine sand</u>	<u>8</u>	<u>94</u>
<u>stopped on chalk</u>		

Information upon completion of well:

(1) Diameter 2" inches.

(2) Total Depth 94 feet.

(3) Water Level 19' feet below top of ground.

(4) Cased to 82, Size 2"


(5) Screen: Size 1 1/4, Length 12'

(6) Were any formations sealed against pollution?
 _____ yes, X no.

If YES depth of formation _____

Why _____

Drillers Remarks: _____

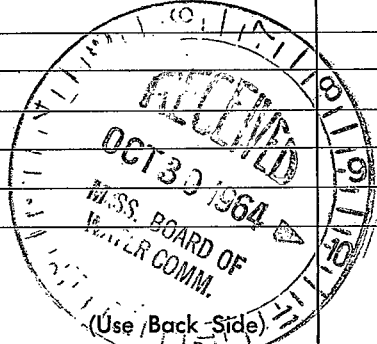

Well No.

