

Wayne
L9
8-67

MISSISSIPPI
BOARD OF WATER COMMISSIONERS
416 North State Street
Jackson, Mississippi 39201

WATER WELL DRILLERS LOG

Aug 15 1967 Porter Drilling & Log Wayne
date well completed firm name county well located

LANDOWNER: Scott West
Azalea Drive
Waynesboro Miss
(mailing address)

WELL LOCATION:
sec. 23 T 9 N R 8 E
S W
8 miles NW of Waynesboro
(distance) (direction) (nearest town)

WELL PURPOSE: home & cattle
(home, irrigation, municipal, industrial)

WELL COMPLETION DATA:

(1) diameter (inches) 2'

(2) total depth (feet) 110

(3) static water level (feet) 72' below above top of ground.

(4) casing steel, 105',
(material) (depth)
2' if telescope see back.
(size)

(5) screen 5', 105'
(length) (depth to top)
1 1/4", S.S.
(size) (material)


(6) pump 1/2, 4
(HP) (yield gpm)
elec
(type power)

(7) electric log no
(yes or no)
(organization running log)

description of formations encountered	from	to
	<u>sand to clay</u>	<u>0</u>
<u>thin rock</u>		<u>13</u>
<u>Chalk</u>	<u>13</u>	<u>30</u>
<u>pea gravel to sand</u>	<u>30</u>	<u>105</u>
<u>small sand</u>	<u>105</u>	<u>111</u>
<u>stagnant white silty</u>		
<u>sh sand</u>		


(8) how well bottom plugged flush point

DRILLERS REMARKS:

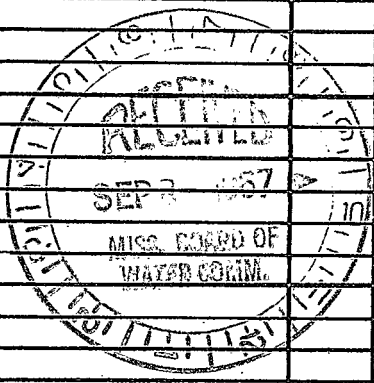

If well telescopes please sketch and show depths.

GROUND LEVEL

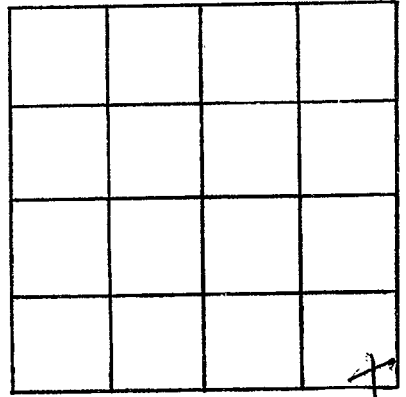

SECTION 23

Please indicate well location X.

ADDITIONAL INFORMATION

If more than one screen,
show locations of each on sketch.