

Wayne  
L 10  
10-67

MISSISSIPPI  
BOARD OF WATER COMMISSIONERS  
416 North State Street  
Jackson, Mississippi 39201

WATER WELL DRILLERS LOG

10-4 1967 Ray West Wayne  
date well completed firm name county well located

LANDOWNER: Eugene Weaver

description of formations encountered	from	to
<u>Sandy Red clay</u>	<u>0</u>	<u>20</u>
<u>Sand</u>	<u>20</u>	<u>60</u>
<u>Sandy Clay</u>	<u>60</u>	<u>90</u>
<u>Sand</u>	<u>90</u>	<u>113</u>

Rt 1  
Waynesboro Miss  
(mailing address)

WELL LOCATION:  
sec. 2 T. 8 N. R. 9 E  
14 miles East of Laud  
(distance) (direction) (nearest town)

WELL PURPOSE: Home  
(home, irrigation, municipal, industrial)


WELL COMPLETION DATA:

- (1) diameter (inches) 2
- (2) total depth (feet) 113
- (3) static water level (feet) 54 below top of ground.
- (4) casing Galv, 108,  
(material) (depth)  
2 if telescope see back.  
(size)
- (5) screen 5 ft, 108  
(length) (depth to top)  
1/4, St Steel  
(size) (material)
- (6) pump 1 7  
(HP) (yield gpm)
- Misspower  
(type power)
- (7) electric log no  
(yes or no)

(organization running log)


(8) how well bottom plugged wash

DRILLERS REMARKS:

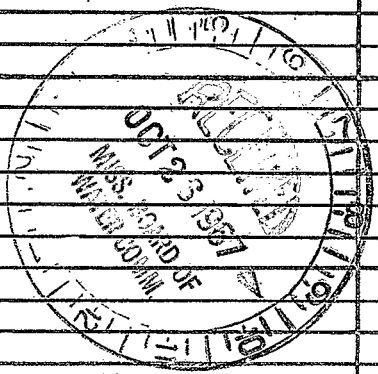

If well telescopes please sketch and show depths.

GROUND LEVEL

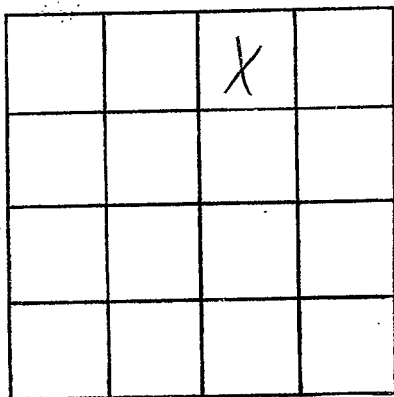

SECTION 2

Please indicate well location X.

ADDITIONAL INFORMATION

If more than one screen, show locations of each on sketch.