

Wayne  
 L11  
 1-68

MISSISSIPPI  
 BOARD OF WATER COMMISSIONERS  
 416 North State Street  
 Jackson, Mississippi 39201

WATER WELL DRILLERS LOG

date well completed 1968 firm name Roy West Water Well Drilling county well located Wayne

LANDOWNER: Guy J. Duantes  
 Rt 6  
 Laurel Miss  
 (mailing address)


description of formations encountered	from	to
	clay	0
sand	10	47

WELL LOCATION:  
 sec. 2 T 8 N R 9 E  
 16 miles SE of Laurel  
 (distance) (direction) (nearest town)

WELL PURPOSE: home  
 (home, irrigation, municipal, industrial)


- WELL COMPLETION DATA:
- (1) diameter (inches) 2
  - (2) total depth (feet) 47
  - (3) static water level (feet) 22 below top of ground.
  - (4) casing Galv 42 (material) (depth)
  - (size) If telescope see back.
  - (5) screen 5 42 (length) (depth to top)
  - 1 1/2 Stainless Steel (size) (material)
  - (6) pump 1/2 6 (HP) (yield gpm)
  - REA (type power)
  - (7) electric log (yes or no)
  - (organization running log)
  - (8) how well bottom plugged wash valve

DRILLERS REMARKS:

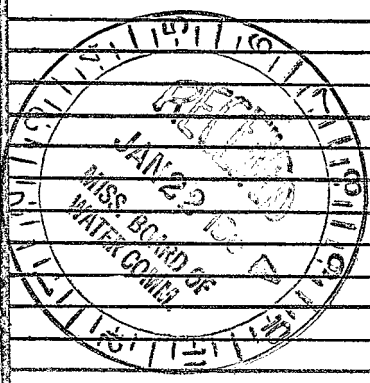

If well telescopes please  
sketch and show depths.

GROUND LEVEL

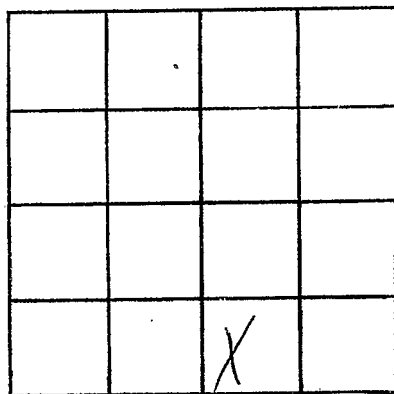

SECTION 2

Please indicate well location X.

ADDITIONAL INFORMATION

If more than one screen,  
show locations of each on sketch.