

Wayne
L12
1-68

MISSISSIPPI
BOARD OF WATER COMMISSIONERS
416 North State Street
Jackson, Mississippi 39201

WATER WELL DRILLERS LOG

1-20 1968 Ray V. West Wayne
date well completed firm name county well located

LANDOWNER: The Chismond Oil Co
Robert Laurel Miss
(mailing address)

description of formations encountered	from	to
	Red clay	0
sand	15	30
Blue clay	30	108
sand	108	115
gray clay	115	170
sand	170	195


WELL LOCATION:
sec. 28 T 8 N R 9 E
S
20 miles S-E of Laurel
(distance) (direction) (nearest town)

WELL PURPOSE:
(home, irrigation, municipal, industrial)

WELL COMPLETION DATA:

- (1) diameter (inches) 2
- (2) total depth (feet) 195
- (3) static water level (feet) 15 below above top of ground.
- (4) casing Galv, 189,
(material) (depth)
- _____ if telescope see back.
(size)
- (5) screen 6, 189
(length) (depth to top)
- 1 1/4, Brass
(size) (material)
- (6) pump 0 20
(HP) (yield gpm)
- _____ (type power)
- (7) electric log No
(yes or no)
- _____ (organization running log)
- (8) how well bottom plugged washed

DRILLERS REMARKS:

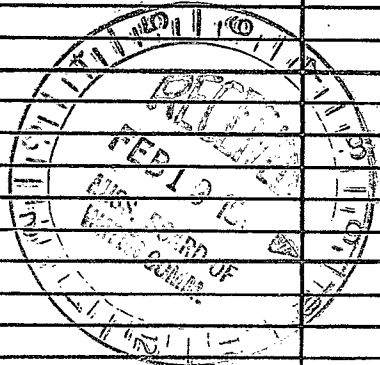

If well telescopes please sketch and show depths.

GROUND LEVEL

X			

SECTION 28

Please indicate well location X.

ADDITIONAL INFORMATION

If more than one screen,
show locations of each on sketch.