

LIB
4-5-63

WATER WELL DRILLERS LOG **CODED**

Date: 4/5, 1963, Driller: C.P. Clark County Wayne
 (Name)
465 508

(1) Owner of Land: T.H. Cooley
 (Name)
Rt #1 Waynesboro
 (Address)

(2) Location: 3/4 3/4, Sec. 35 T. 8 R. 9
1 miles East of Stungful
 (distance) (direction) (Nearest Town)

(3) Topography: (Hilly) (Flat) (Level)

(4) Purpose of Well: Domestic
 (Domestic Irrigation, Municipal, Industrial, Other)

Description & Color of Materials Sand, Clay, Red Clay, Shell, etc.	Thick- ness Feet	Depth Feet
<u>0-60 Clay</u>	<u>60</u>	
<u>60-72 Sand fine</u>	<u>12</u>	
<u>72-135 Clay + rocks</u>	<u>63</u>	
<u>135-152 Sand</u>	<u>18</u>	

Information upon completion of well:

(1) Diameter 2 inches.

(2) Total Depth 152 feet.

(3) Water Level 0 feet below top of ground.

(4) Cased to 141, Size 2 in


(5) Screen: Size 1/4, Length 5 ft

(6) Were any formations sealed against pollution?
 _____ yes, no.

If YES depth of formation _____

Why _____

Drillers Remarks
Well flowed 4 1/2 PM

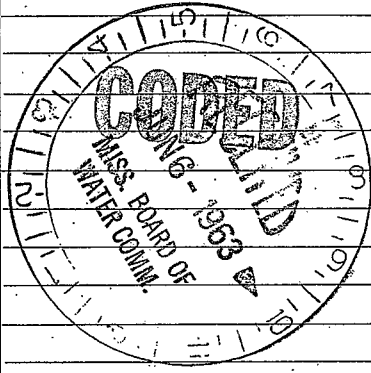

(Use Back Side)

Well No.

