

**MISSISSIPPI
BOARD OF WATER COMMISSIONERS**
416 North State Street
Jackson, Mississippi 39201

WATER WELL DRILLERS LOG

WAYNE
L 14
4-68

4-13 19**68** **Roy V. West** **Wayne**
date well completed firm name county well located

LANDOWNER: *Marlyn Smith*
Rt 1
Laurel Miss
(mailing address)

description of formations encountered

from	to
0	5
5	12
12	98
98	121

Clay
Sandy clay
gray clay
sand


WELL LOCATION:
sec. 5 T. 8 N. R. 9 E
12 miles E of Laurel
(distance) (direction) (nearest town)

WELL PURPOSE: *home*
(home, irrigation, municipal, industrial)

WELL COMPLETION DATA:

- (1) diameter (inches) 2 in
- (2) total depth (feet) 121
- (3) static water level (feet) 35 ^{below} ~~above~~ top of ground.
- (4) casing Galv 115
(material) (depth)
 if telescope see back.
(size)
- (5) screen 6 115
(length) (depth to top)
1/4 Brass
(size) (material)
- (6) pump 1/2 6
(HP) (yield gpm)
Rea
(type power)
- (7) electric log No
(yes or no)


(organization running log)
- (8) how well bottom plugged Washed

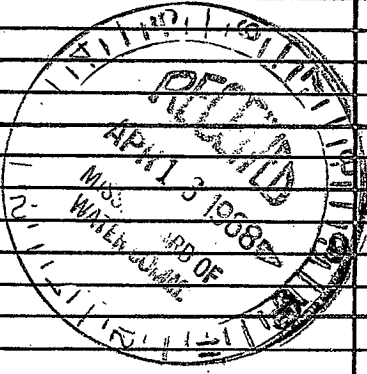

DRILLERS REMARKS:

If well telescopes please sketch and show depths.

GROUND LEVEL

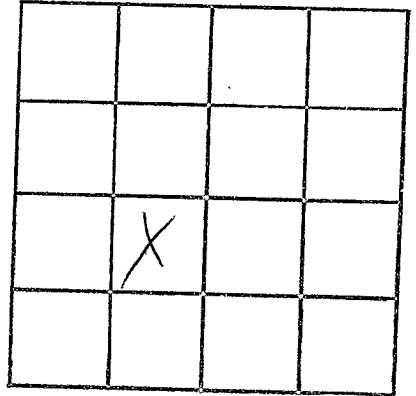

SECTION 5

Please indicate well location X.

ADDITIONAL INFORMATION

Lined area for additional information.

If more than one screen, show locations of each on sketch.