

Wayne
 L 15
 6-68

MISSISSIPPI
 BOARD OF WATER COMMISSIONERS
 416 North State Street
 Jackson, Mississippi 39201

CODED

WATER WELL DRILLERS LOG

10-12-68 date well completed
 Roy V. West Wayne firm name
 county well located

LANDOWNER: Thompson Creek
 Greenville Baptist Church
 Rt 1 Laurel
 (mailing address)

description of formations encountered	from	to
Clay	0	10
Sand	10	60

WELL LOCATION:
 sec. 13 T 8 N R 9 E
 15 miles S. E of Laurel
 (distance) (direction) (nearest town)

WELL PURPOSE: home
 (home, irrigation, municipal, industrial)


- WELL COMPLETION DATA:
- (1) diameter (inches) 2 in
 - (2) total depth (feet) 60
 - (3) static water level (feet) 8 below above
top of ground.
 - (4) casing galv, 55
(material) (depth)
if telescope see back.
(size)
 - (5) screen 5 ft, 55
(length) (depth to top)
1/4, St Steel
(size) (material)
 - (6) pump 7/4, 10
(HP) (yield gpm)
Rea
(type power)
 - (7) electric log no
(yes or no)
(organization running log)
 - (8) how well bottom plugged washed

JUN 19 1968
 MISS. GOV. REG
 WATER DEPT.

DRILLERS REMARKS:

If well telescopes please sketch and show depths.

GROUND LEVEL

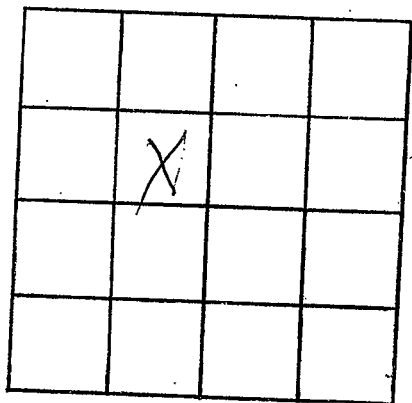

SECTION 13

Please indicate well location X.

ADDITIONAL INFORMATION

If more than one screen, show locations of each on sketch.