

Wayne
L 17
9-16-68

MISSISSIPPI
BOARD OF WATER COMMISSIONERS
416 North State Street
Jackson, Mississippi 39201

CODED

WATER WELL DRILLERS LOG

9-16-1968 date well completed
68 Ray V. West firm name
Wayne county well located

LANDOWNER: D. M. Lopez
Rt 4
Laural Miss
(mailing address)

description of fomations encountered	from	to
⊙ sandy clay	0	30
clay	30	68
clay sand	68	75
clay sand	75	100
clay sand	100	107
clay sand	107	135
clay sand	135	142
clay sand	142	160
clay sand	160	186


WELL LOCATION:
sec 34 T 8 N R 9 E
20 miles S E of Laural
(distance) (direction) (nearest town)

WELL PURPOSE: home
(home, irrigation, municipal, industrial)

WELL COMPLETION DATA:

(1) diameter (inches) 2
(2) total depth (feet) 186
(3) static water level (feet) 3 below top of ground.
(4) casing galv, 176 (material) (depth)
⊙ if telescope see back. (size)
(5) screen 10, 176 (length) (depth to top)
1/4, st steel (size) (material)
(6) pump 18 (HP) (yield gpm)
(type power)
(7) electric log No (yes or no)
(organization running log)
(8) how well bottom plugged washed


CODED

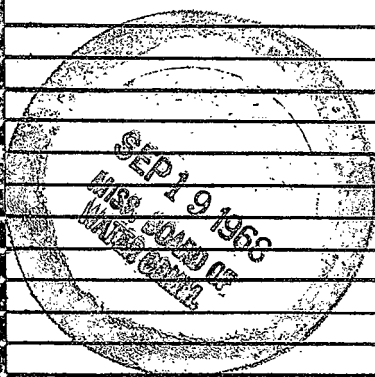

DRILLERS REMARKS:

If well telescopes please sketch and show depths.

GROUND LEVEL

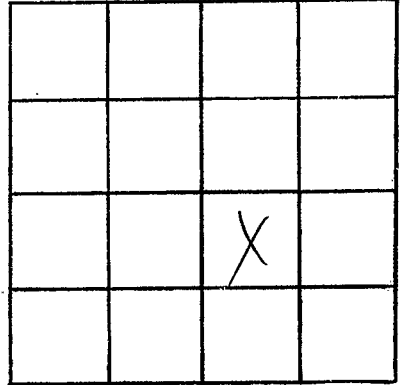

SECTION 34

Please indicate well location X.

ADDITIONAL INFORMATION

If more than one screen,
show locations of each on sketch.