

INDEXED

WAYNE
L18
3-31-69

MISSISSIPPI
BOARD OF WATER COMMISSIONERS
416 North State Street
Jackson, Mississippi 39201

WATER WELL DRILLERS LOG

Mar 31 1969 Roy West Wayne
date well completed firm name county well located

LANDOWNER: Eugene Weaver
Rt 6 Laurel
(mailing address)

description of formations encountered	from	to
	sand	0
clay	65	105
sand	105	131

WELL LOCATION:
sec. 2 T. 8 N. R. 9 E
15 miles E of Laurel
(distance) (direction) (nearest town)

WELL PURPOSE: Chickenhouse
(home, irrigation, municipal, industrial)

- WELL COMPLETION DATA:
- (1) diameter (inches) 2
 - (2) total depth (feet) 131
 - (3) static water level (feet) 62 below top of ground.
 - (4) casing galv. 126 (material) (depth)
 - (size) If telescope see back.
 - (5) screen 5 126 (length) (depth, to top)
 - 1/4 St Steel (size) (material)
 - (6) pump 1/2 10 (HP) (yield gpm)
 - Koa (type power)
 - (7) electric log No (yes or no)
 - (organization running log)
 - (8) how well bottom plugged wash hole

DRILLERS REMARKS:


LOG # 1009

MAR 31 1969

MISS. Bd. OF WATER COMMISSIONERS

If well telescopes please sketch and show depths.

GROUND LEVEL

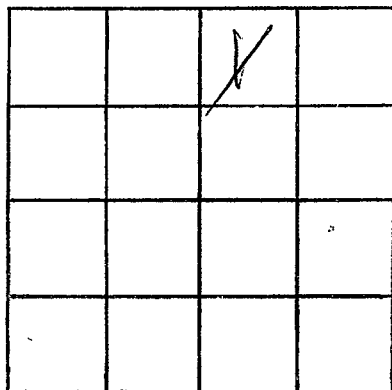

SECTION 2

Please indicate well location X.

ADDITIONAL INFORMATION

If more than one screen,
show locations of each on sketch.