

CODED

Wayne  
L 20  
5-19-69

MISSISSIPPI  
BOARD OF WATER COMMISSIONERS  
416 North State Street  
Jackson, Mississippi 39201

WATER WELL DRILLERS LOG

5-19 date well completed 1969 Roy West firm name Wayne county well located

LANDOWNER: Luther West  
Rt 4  
Laurel Miss  
(mailing address)

description of formations encountered	from	to
Clay	0	10
Sandy clay	10	40
clay	40	60
Round clay	60	100
Round	100	120

WELL LOCATION:  
sec. 31 T 8 N R 9 E  
1.5 miles S.E. of Laurel  
(distance) (direction) (nearest town)

WELL PURPOSE: home  
(home, irrigation, municipal, industrial)

- WELL COMPLETION DATA:
- (1) diameter (inches) 2
  - (2) total depth (feet) 120
  - (3) static water level (feet) 40 below top of ground.
  - (4) casing plastic 115 (material) (depth)
  - (5) screen 5 115 (length) (depth to top)  
1 1/4 St Steel (size) (material)
  - (6) pump 3/4 8 (HP) (yield gpm)  
REA (type power)
  - (7) electric log no (yes or no)

(organization running log)

(8) how well bottom plugged washhole


JUN 11 1969

DRILLERS REMARKS:

MISC. DU. OR  
WATER COMM.

If well telescopes please sketch and show depths.

GROUND LEVEL

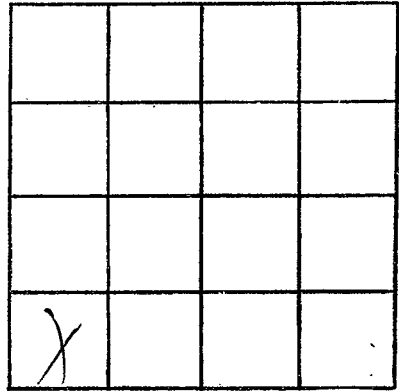

SECTION 31

Please indicate well location X.

ADDITIONAL INFORMATION

If more than one screen, show locations of each on sketch.